


#18766A

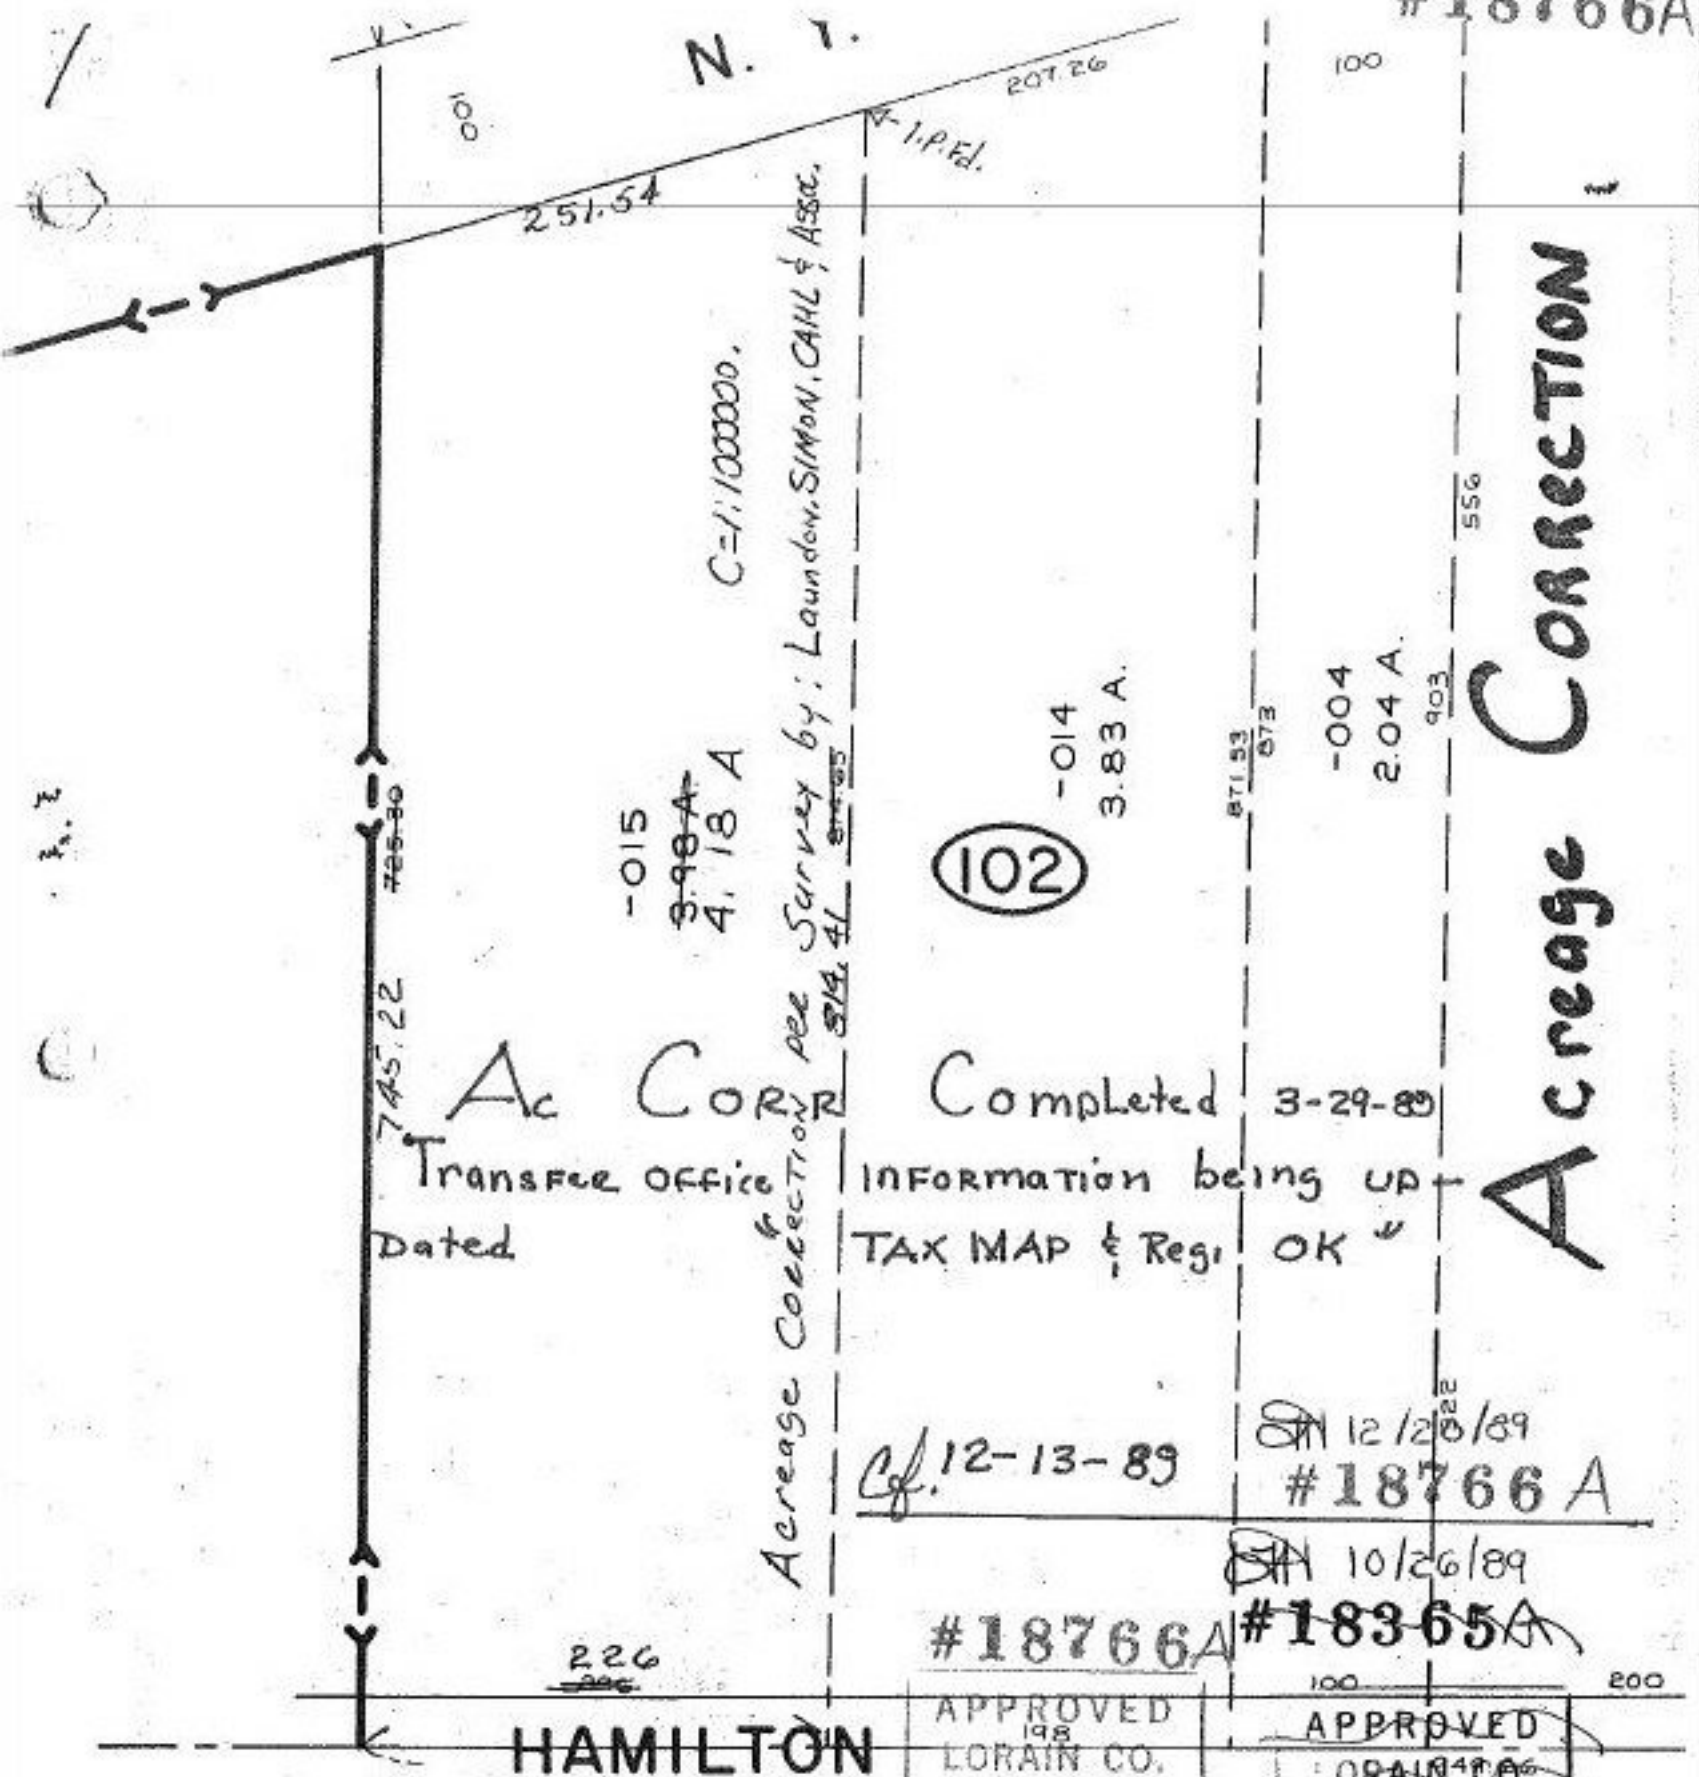

-015  
~~3-98-A~~  
 4, 18 A C=1:1000000.

(102)

-014  
 3.83 A.

871.53  
 873

-004  
 2.04 A.

556

Ac CORP  
 Transfer Office  
 Dated

Completed 3-29-89  
 Information being up  
 TAX MAP & Regi OK

Acresage Correction

Cf. 12-13-89

SN 12/20/89  
 #18766A

SN 10/26/89  
 #18365A

#18766A

#18365A

HAMILTON

APPROVED  
 198  
 LORAIN CO.  
 MAP DEPT.  
 DATE 12-13-89  
 PAGE 9-00-094-B  
 BY Carolyn Francis  
 VOID AFTER # 18766A

APPROVED  
 LORAIN CO.  
 MAP DEPT.  
 DATE 3-29-89  
 PAGE 9-00-094-B  
 BY CAROL FRANCIS  
 VOID AFTER # 18365-A

09-00-094-102-  
 ACREAGES CORRECTION COMPLETED IN  
 TAX MAP OFFICE 3-29-89  
 SEE # 18365-A