


-009 4.30A
 SWIT 1.24A
 REM: 3.06A

05-00-087-000- PRIOR INST. 1177/781
 SURVEYED BY: KS ASSOC. C=1: INF. ✓

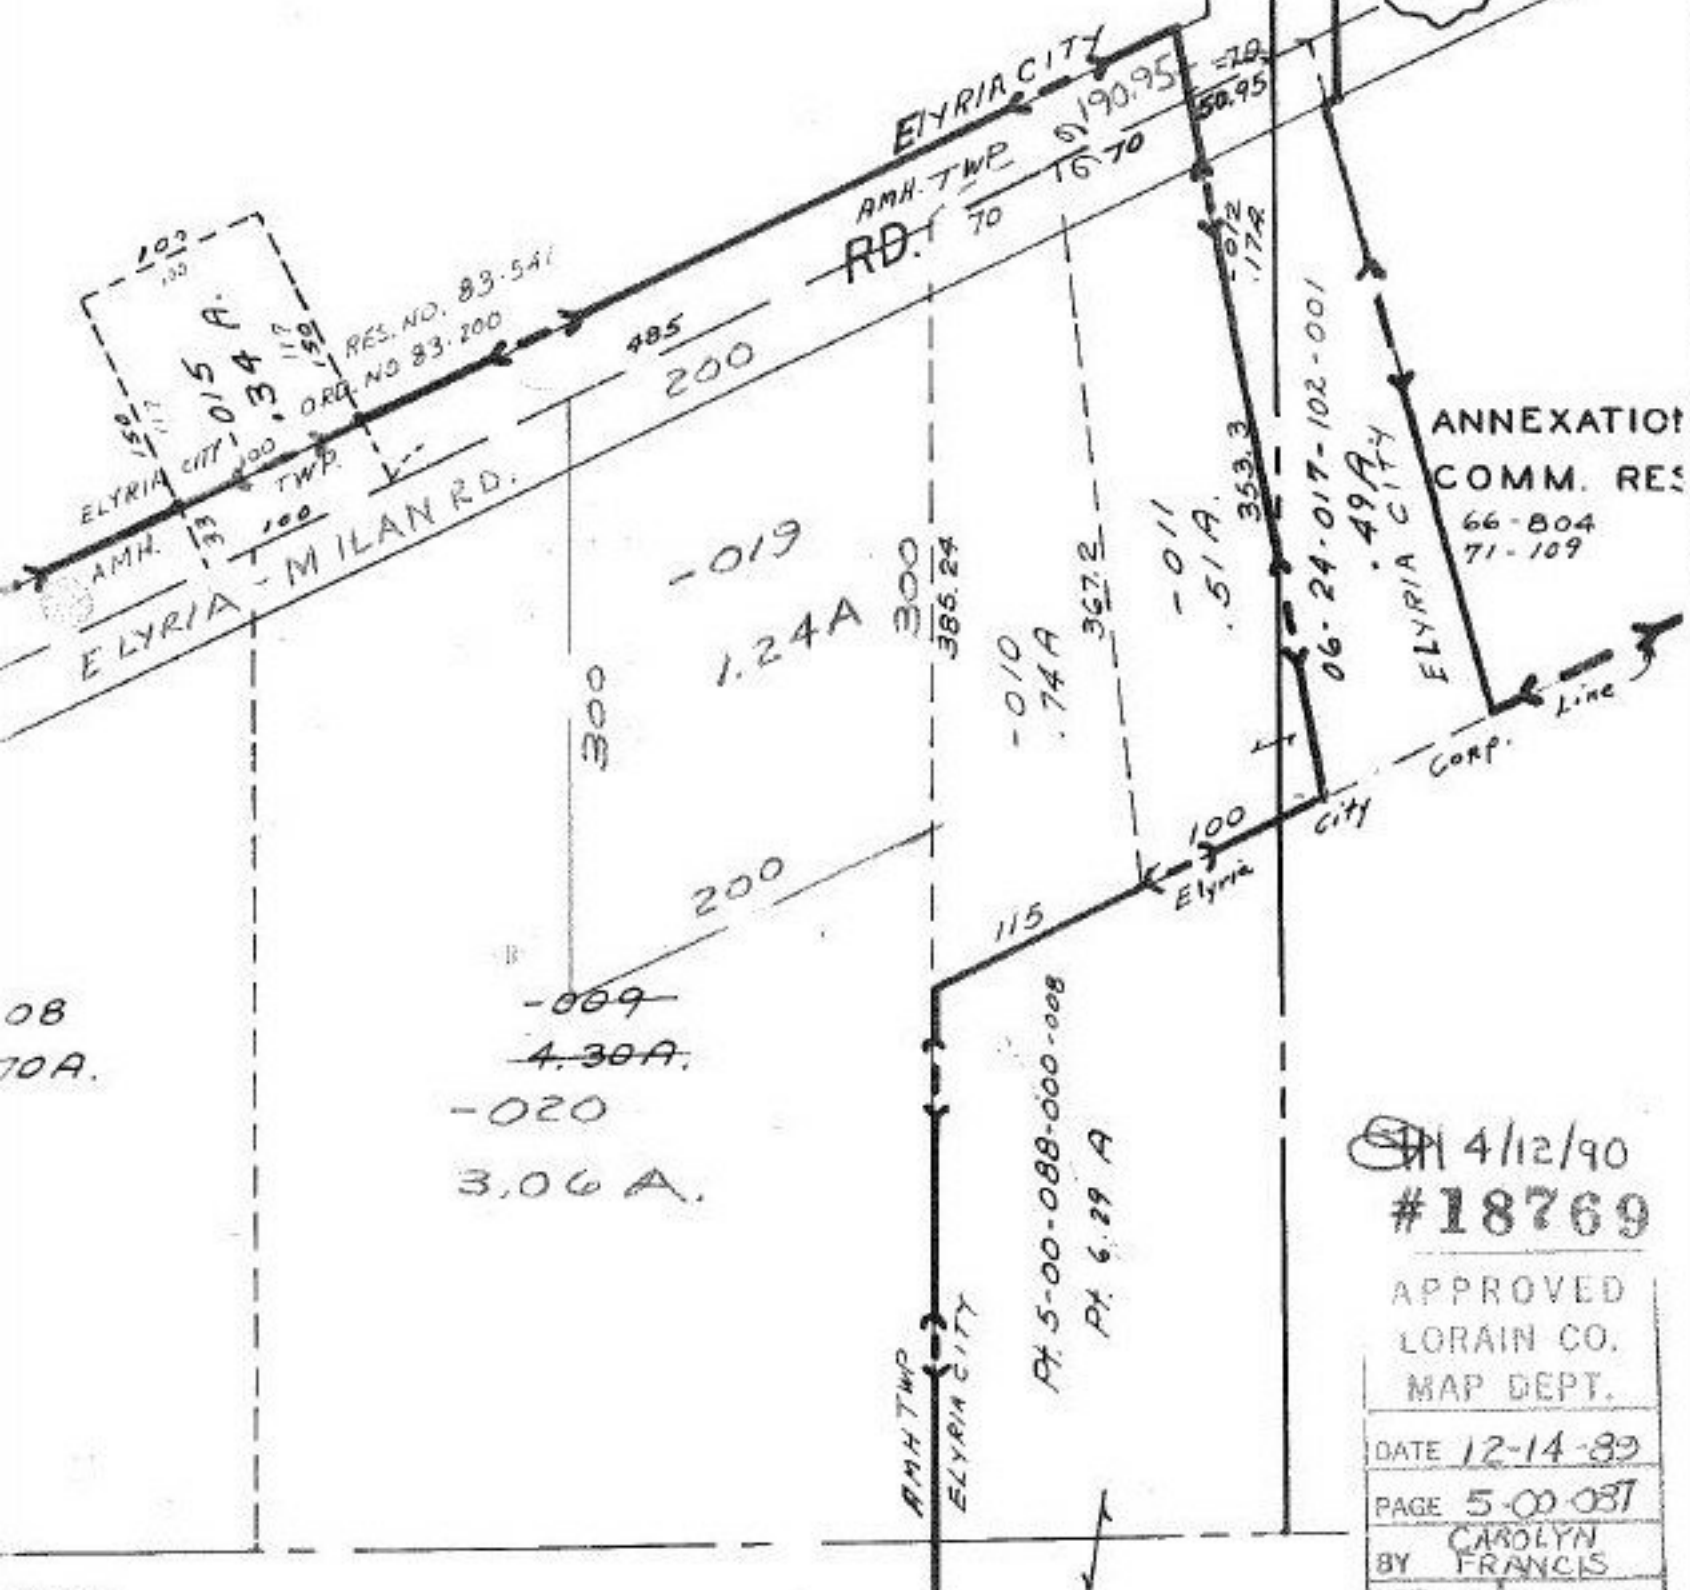

08
 70A.

~~-009~~
~~4.30A.~~
 -020
 3.06A.

4/12/90
 #18769

APPROVED
 LORAIN CO.
 MAP DEPT.

DATE 12-14-89

PAGE 5-00-087

BY CAROLYN
 FRANCIS

VOID AFTER # 18769

088