


1878

740.83


APPROVED
LORAIN CO.
MAP DEPT.
DATE 6-19-68
2-03-001-C
BY <i>J. Colburn</i>

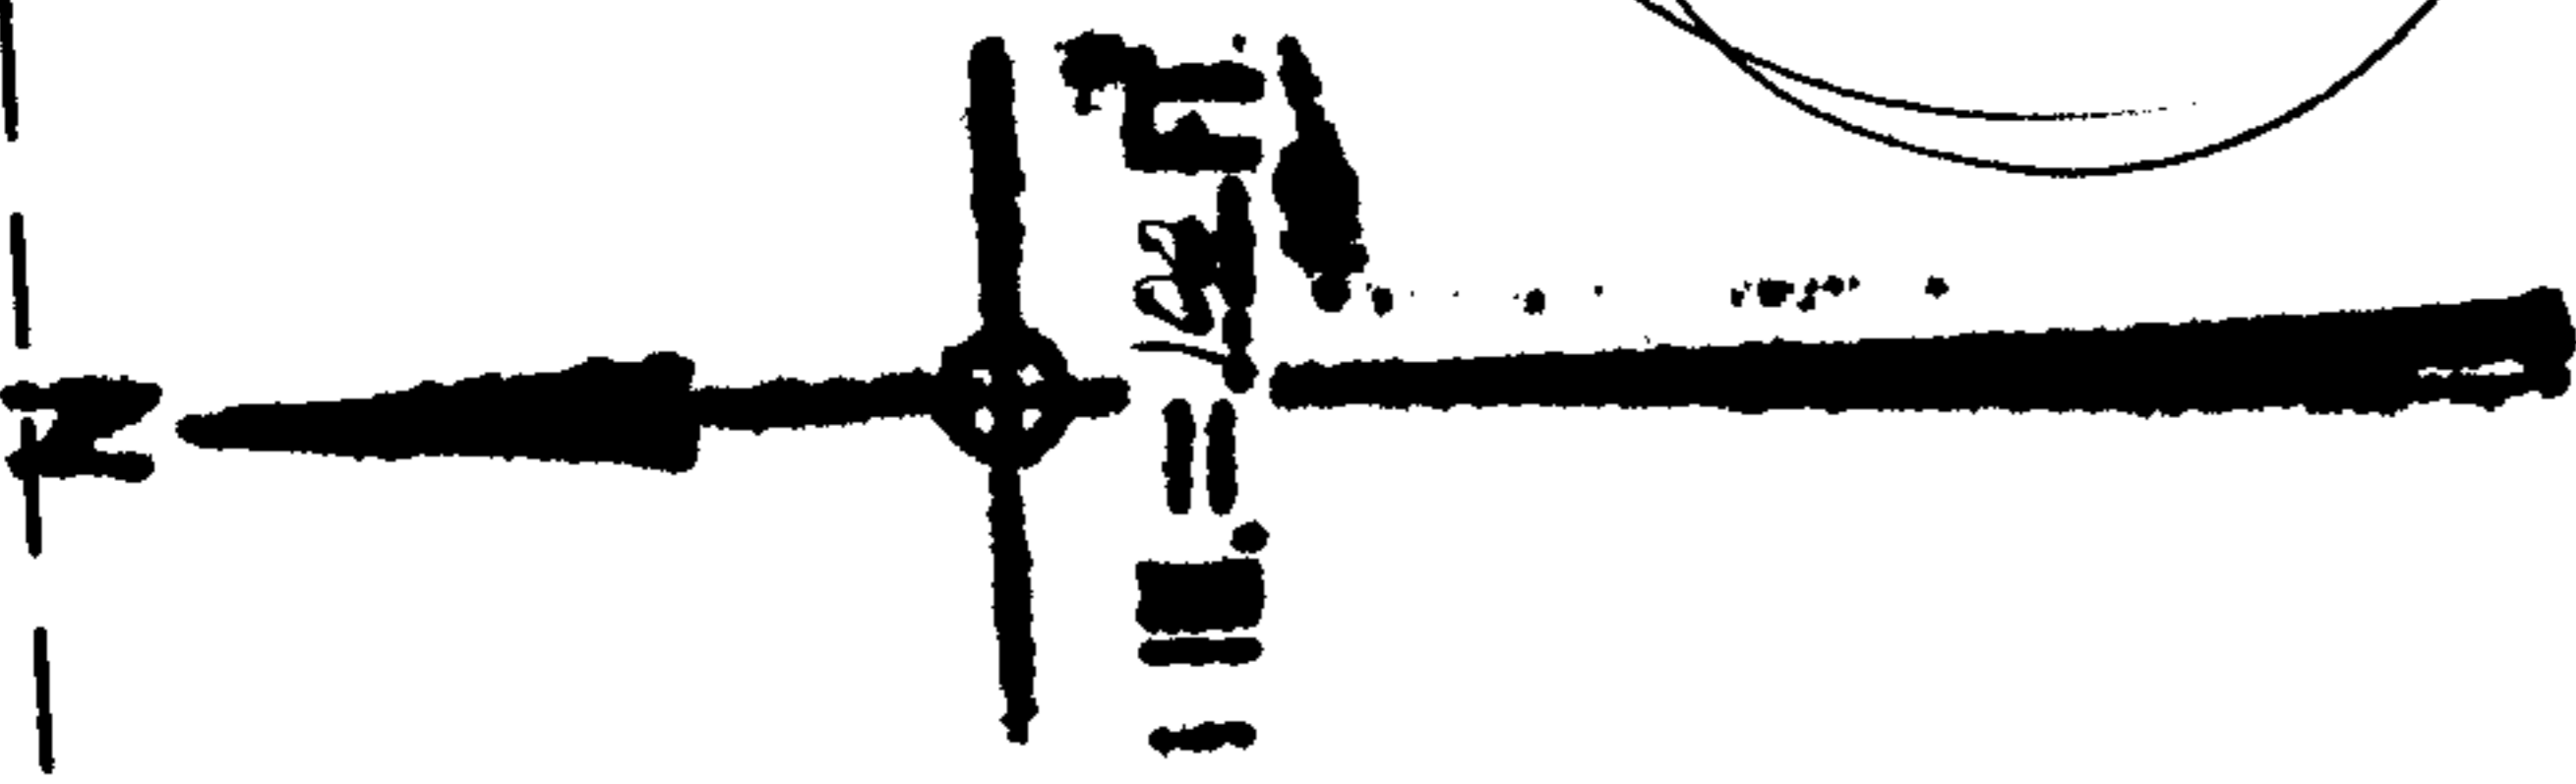

-003
8.23A.



7-14-68
S.S.

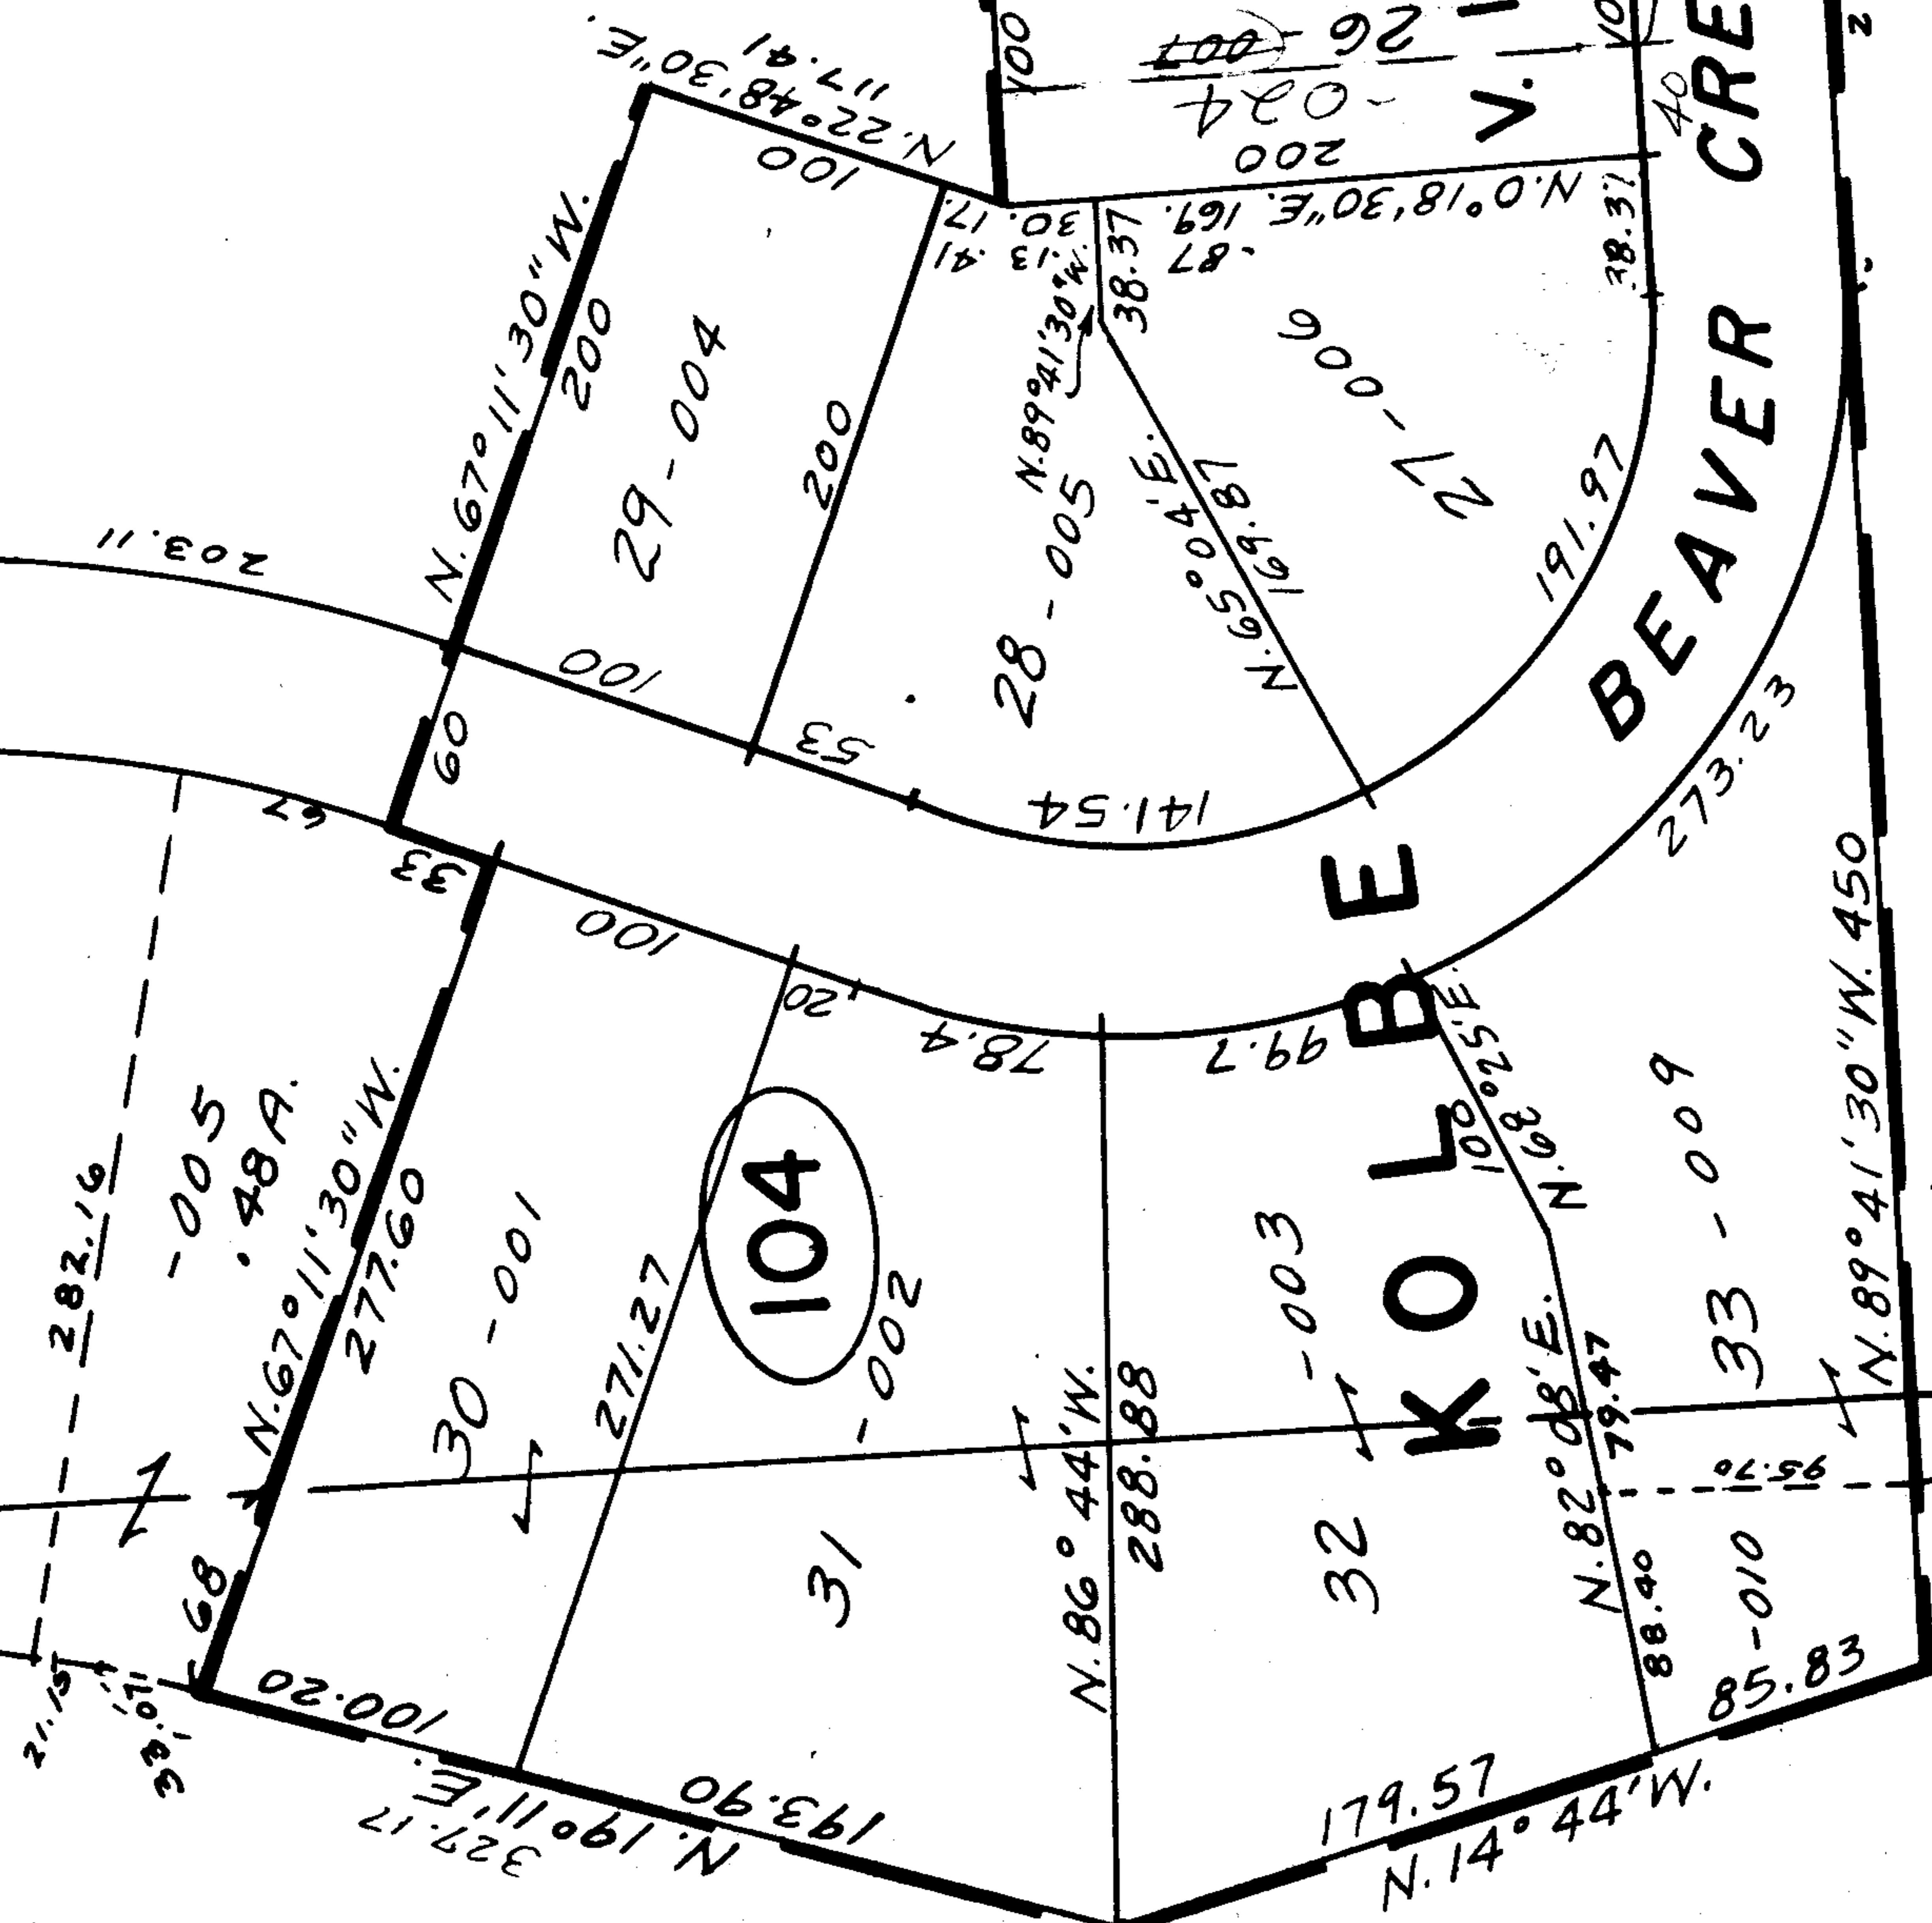

104

ACRES
25-008
26-007
27-006
28-005
29-004
24-009
23-000
22-012

BEAVER CREST

KOLBE

W Hall
22-012
N 0°18'30"E

-013
2.81A.

6-20-68

02-03-001-103-023

Donc 7-6-68

265

49.51

201.36

296.87

282.16

-005
48A.

277.60

30-001

271.27

31-002

N. 86° 44' W.

288.88

32-003

N. 82° 08' E.

79.47

33-009

N. 89° 41' 30" W.

450

158.17

88.40

85-010

95.71

179.57

N. 14° 44' W.

193.90

327.17

100.20

21.15

33.17

109.16

21.15

21.15

