


RD.

WOODSTER AVENUE LAKE RD

AC. CORR.

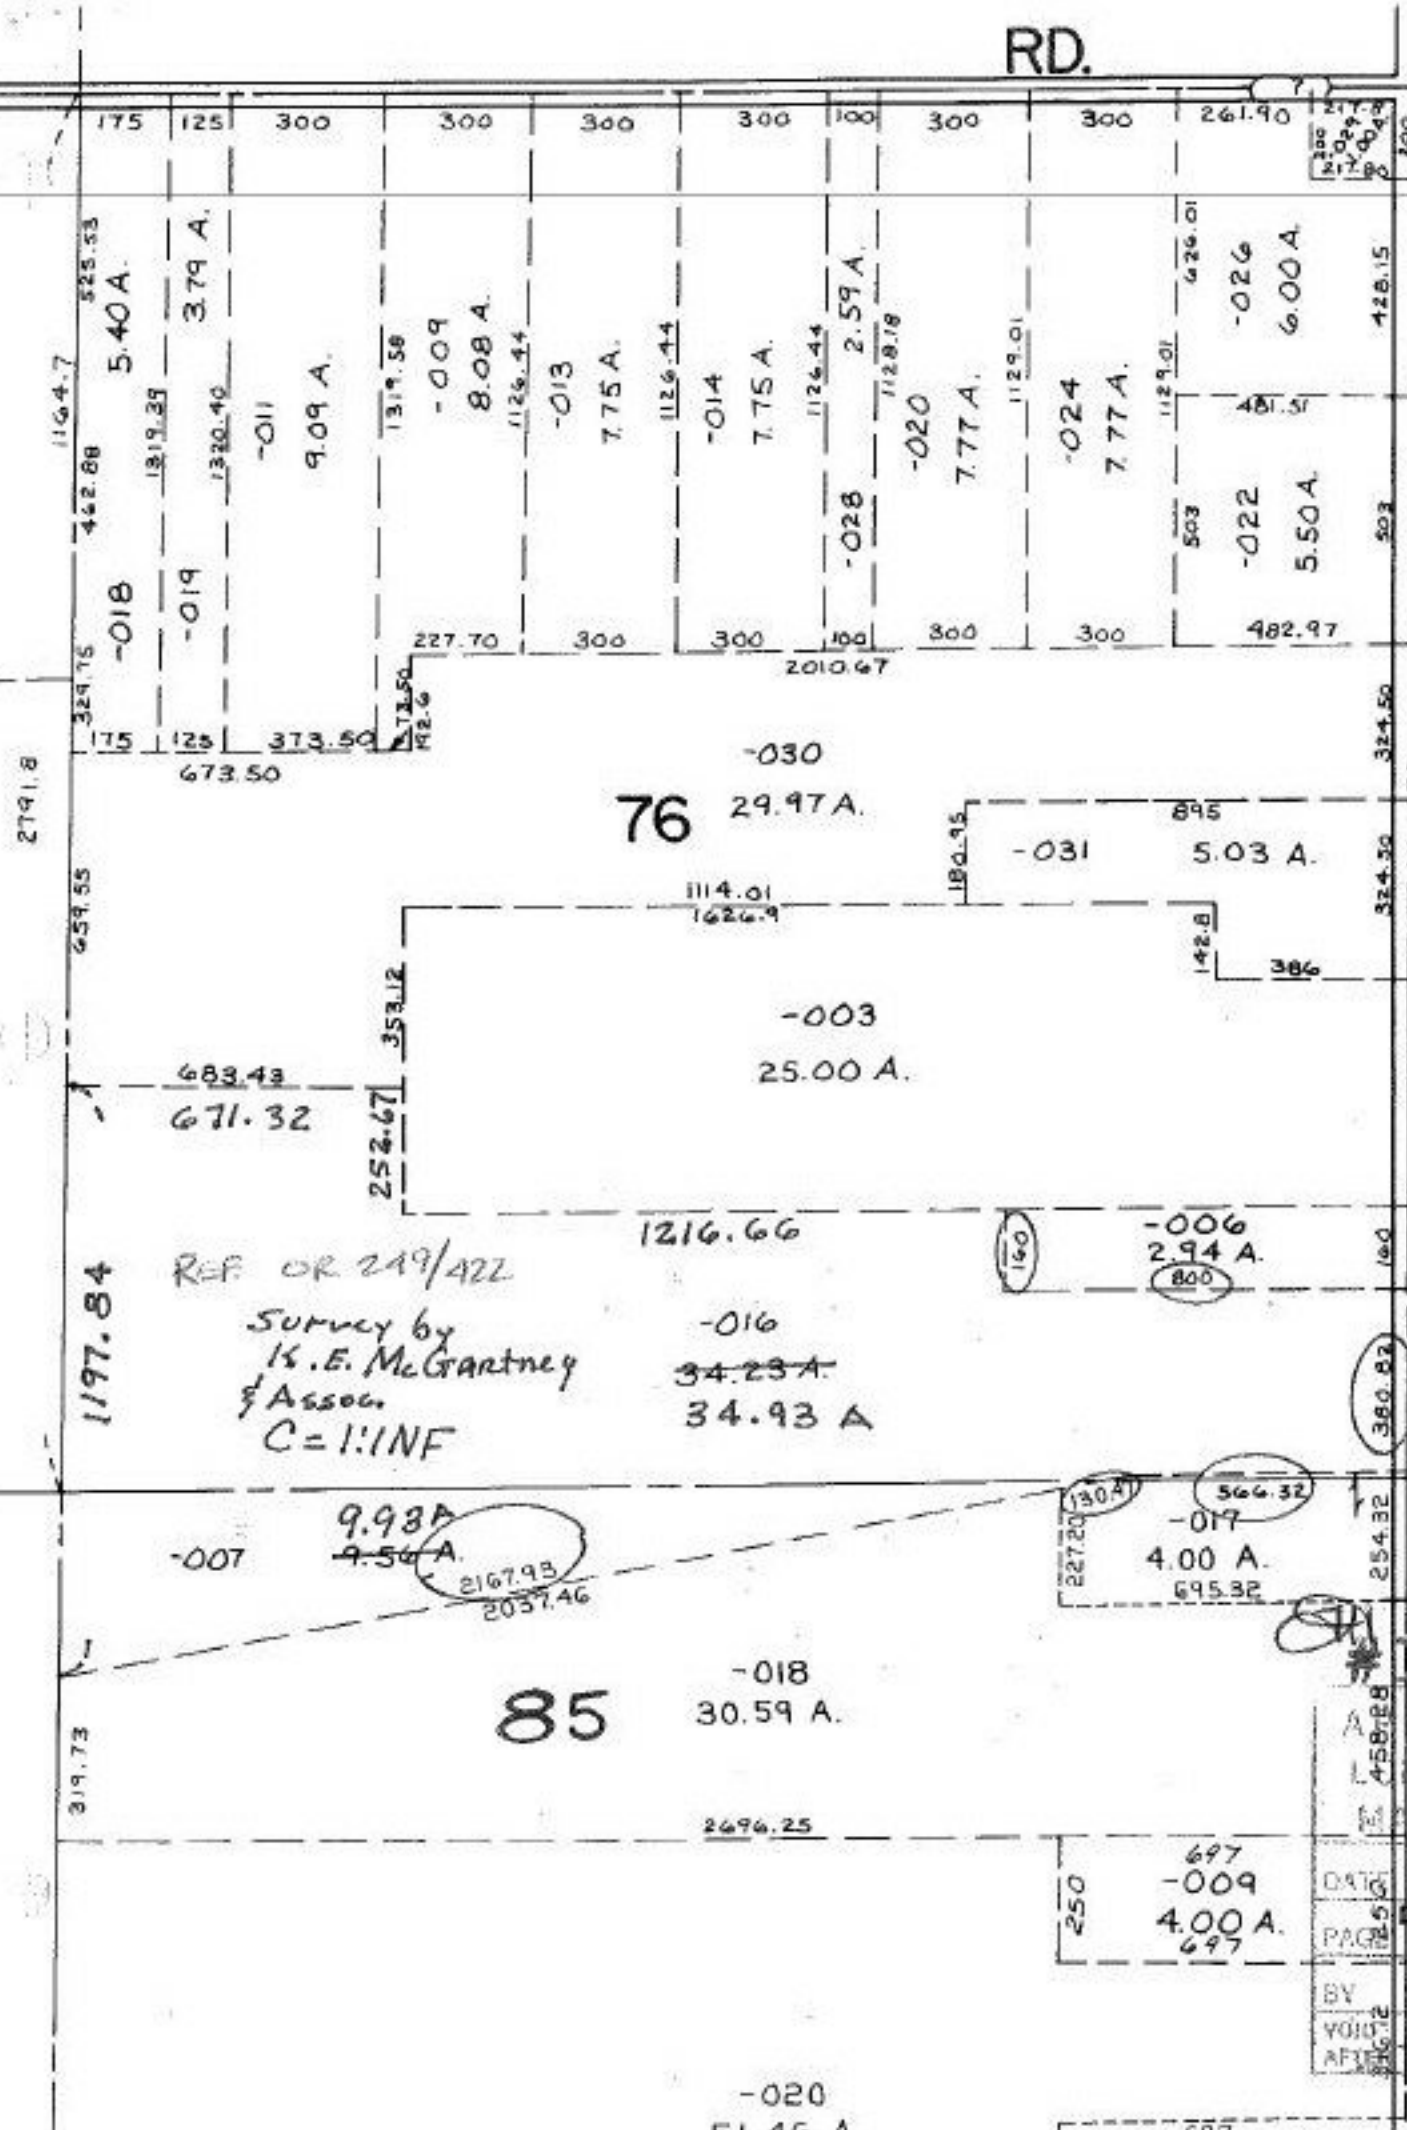

9/25/90
 #18798A
 APPROVED
 L. RAIN CO.
 MAP DEPT.
 DATE 5-31-90
 PAGE 16 BOX F
 BY CAROLYN FRANCIS
 #18798-A