


RD.

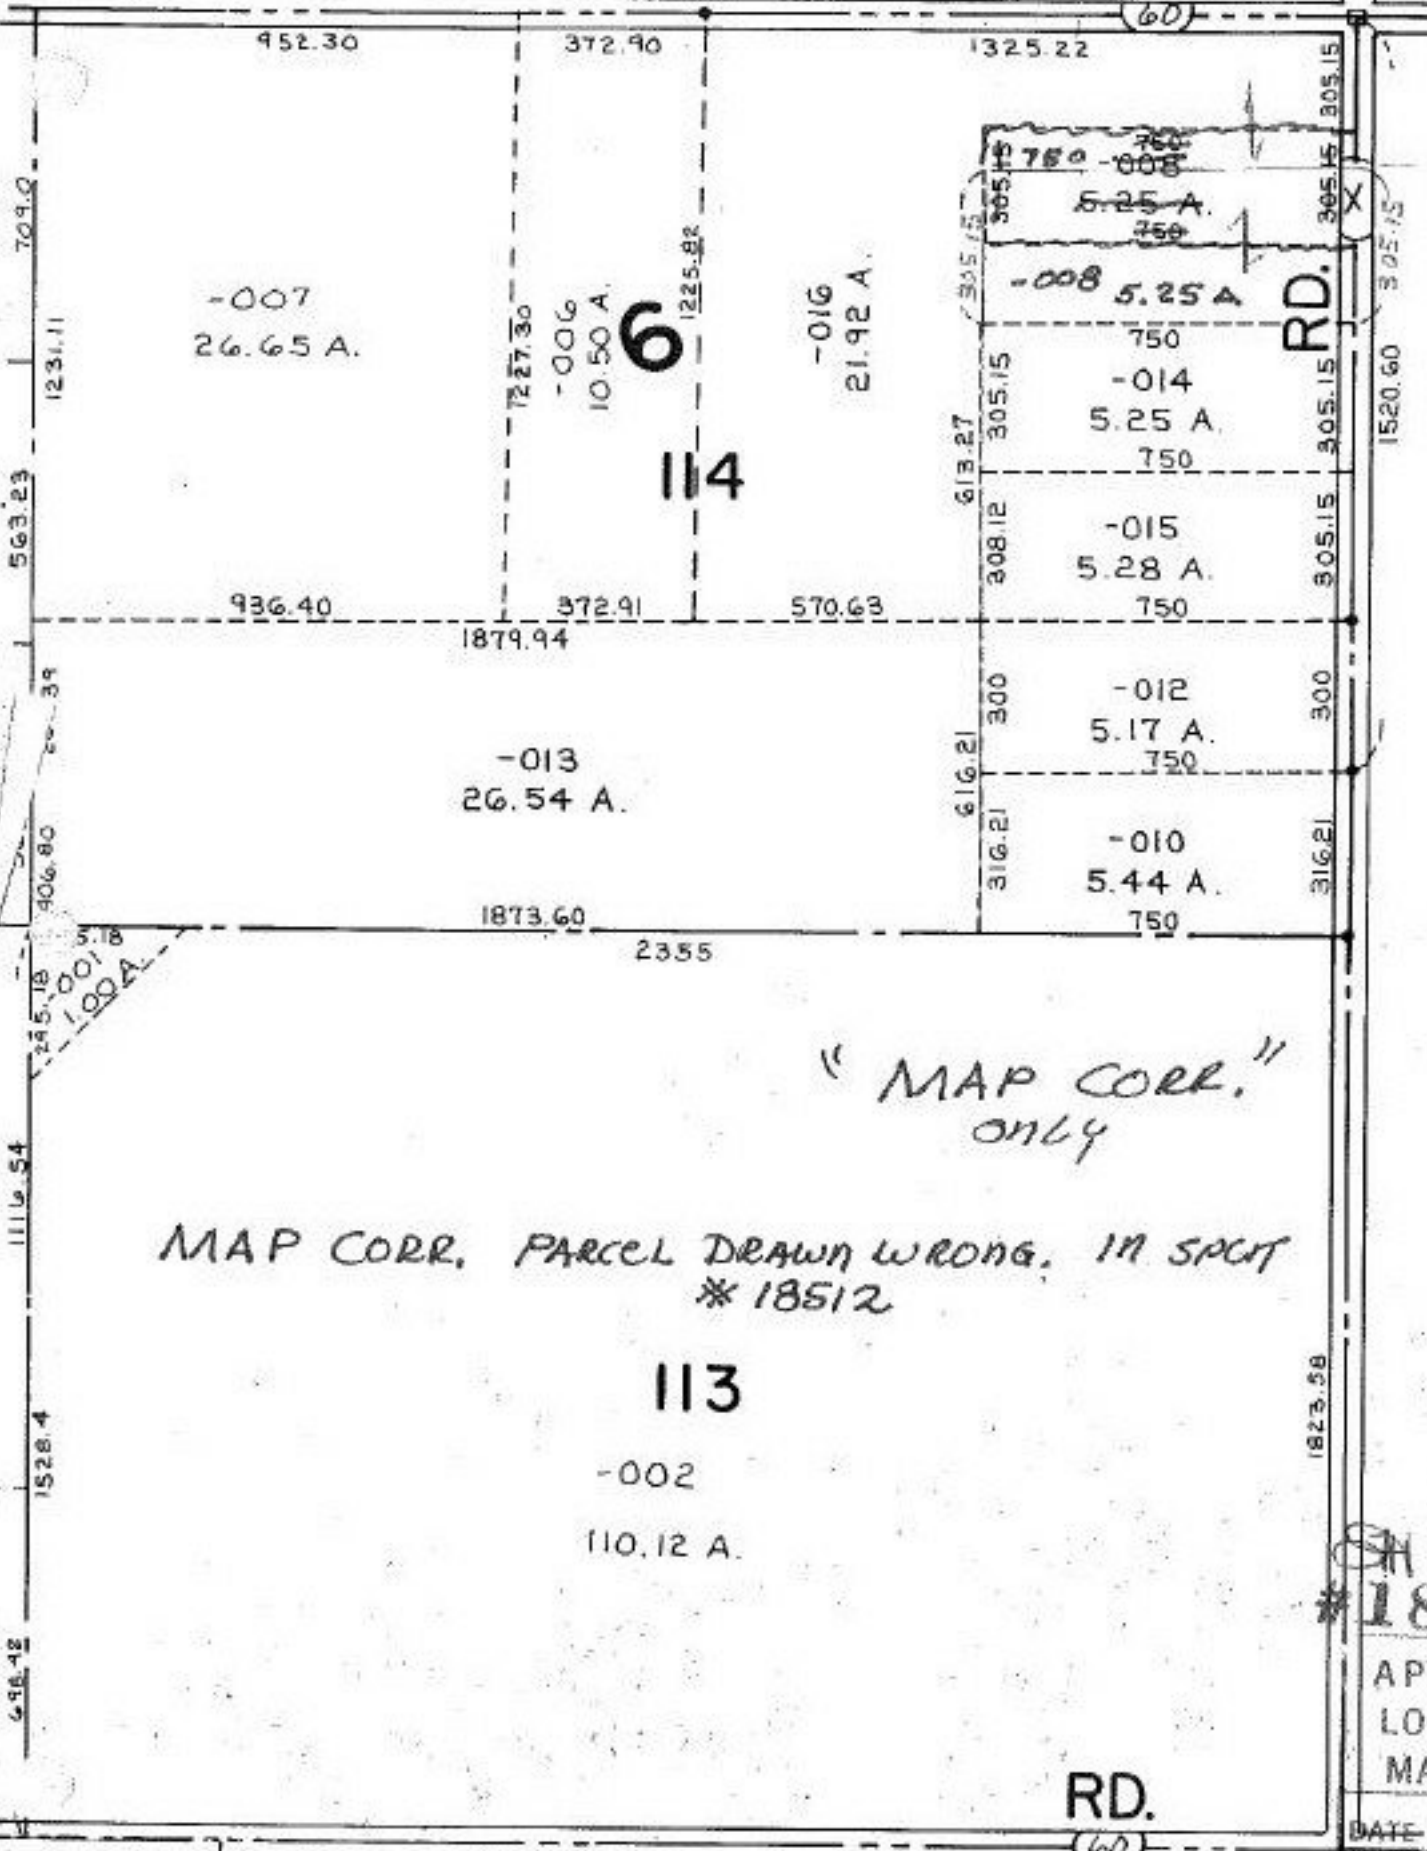

"MAP CORR."  
ONLY

MAP CORR. PARCEL DRAWN WRONG. IN SPOT  
\*18512

113

-002  
110.12 A.

1823.58

RD.

SH 115/90  
#18800A

APPROVED  
LORAIN CO.  
MAP DEPT.

DATE 1-4-90

PAGE 19-A  
BY CAROLYN  
FRANCIS

VOID  
# 1880A