


82

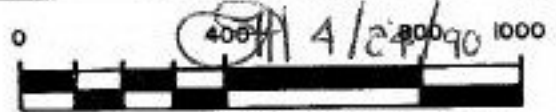

LOTS 76 THRU 85, 96 THRU 100

AC CORR is FOR THE PURPOSE TO
 CORR. TRANSFER SHEET & REGISTER
 TAX MAP OK

APPROVED
LORAIN CO.
MAP DEPT.
DATE 1-8-90
PAGE 12-A
BY CAROLYN FRANCIS
VOID AFTER # 18802A