



CITY TWP

102

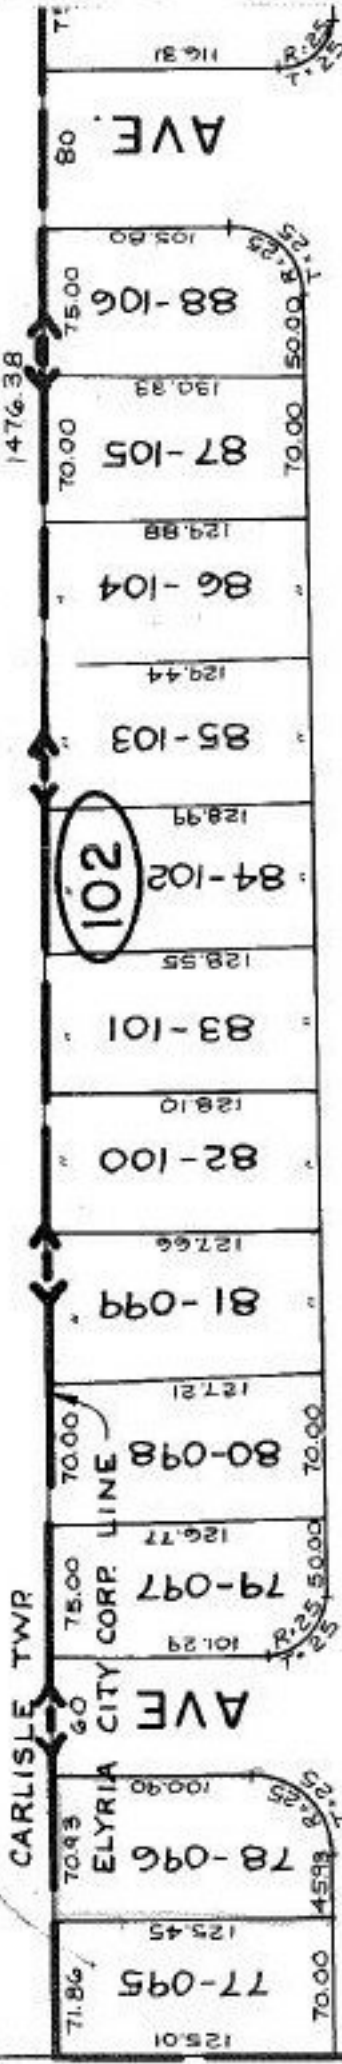


CAROL

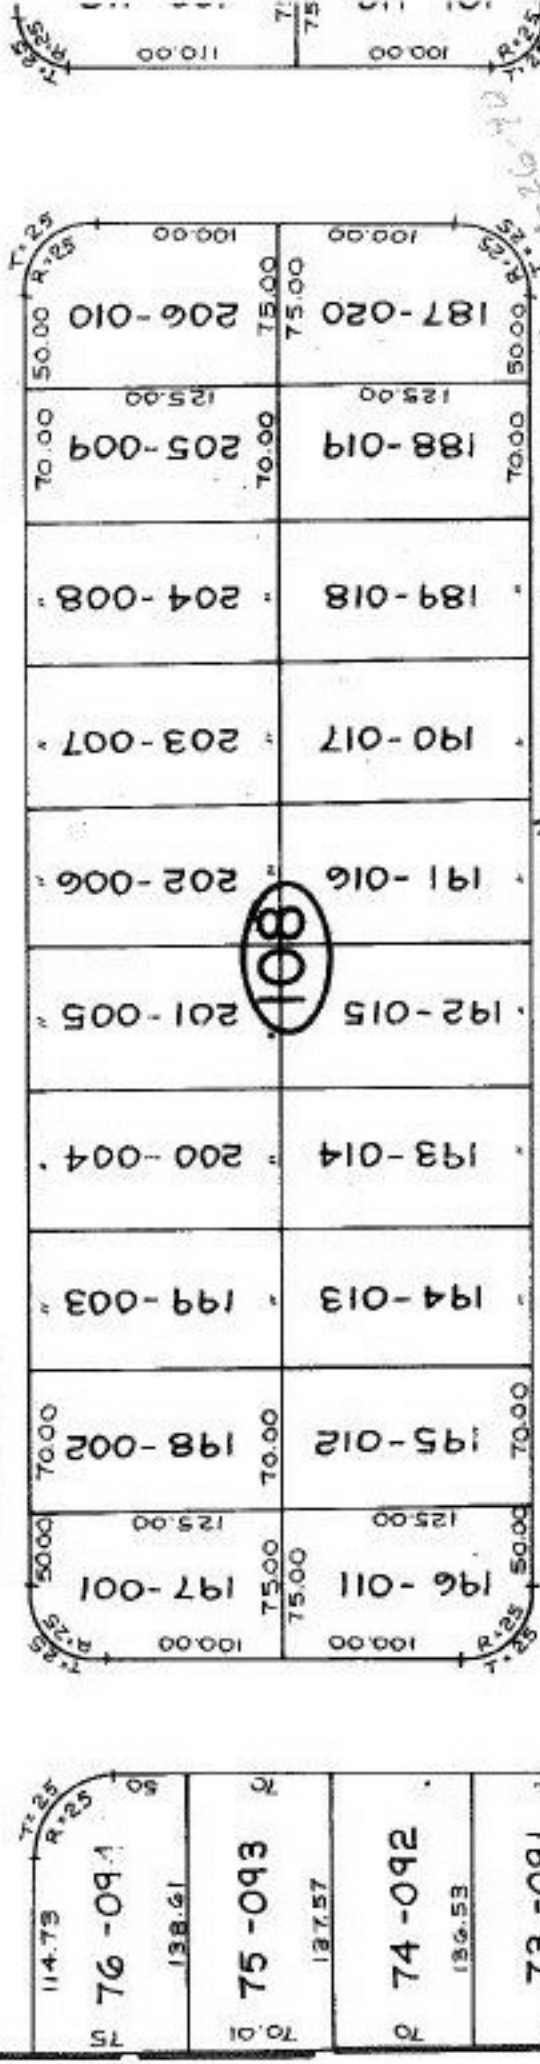

IDAHO DEPTH CORR - TAX MAP OK

#18803A

10-00-005-102-096

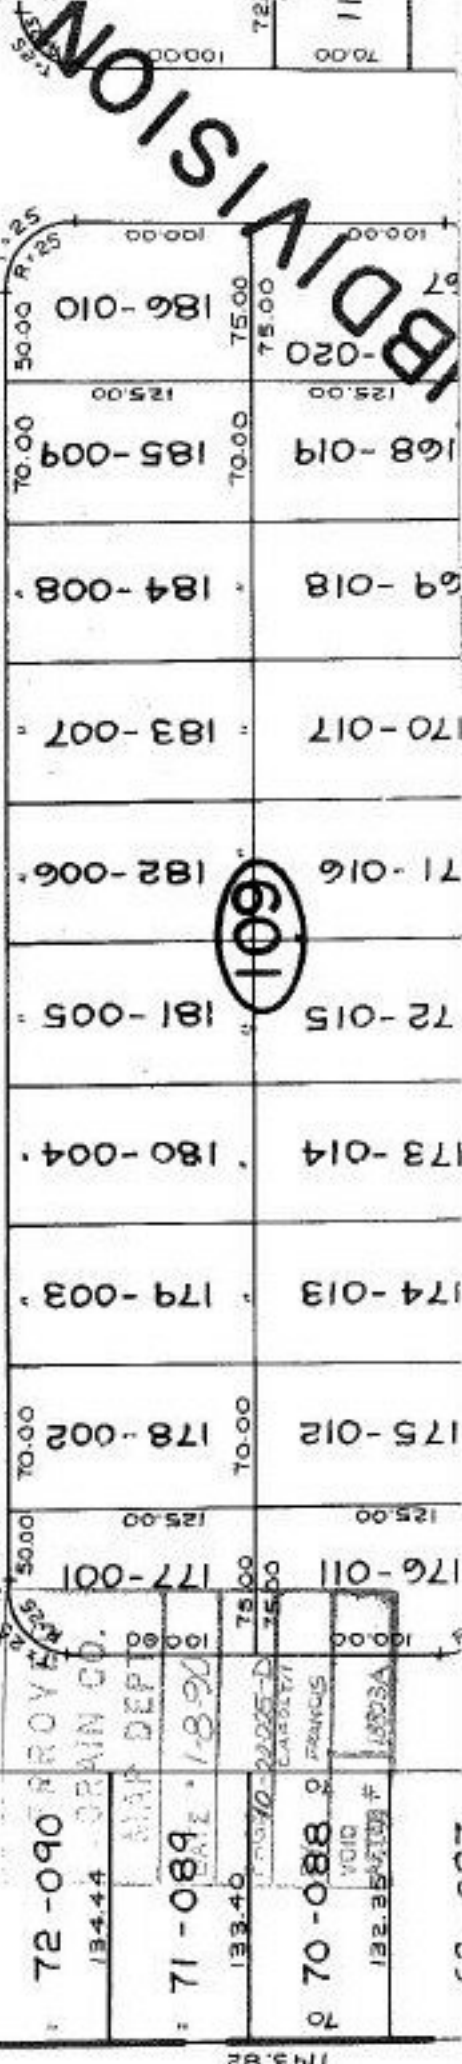

72-090 PROVED  
 134.44 ORAIN CO.  
 MAP DEP  
 71-089 133.40  
 10-00-005-102-096  
 CAROL TWP  
 70-088 132.35  
 VOID  
 FRANCIS  
 #18803A

BD DIVISION  
 70.00 70.00  
 72.00 72.00