
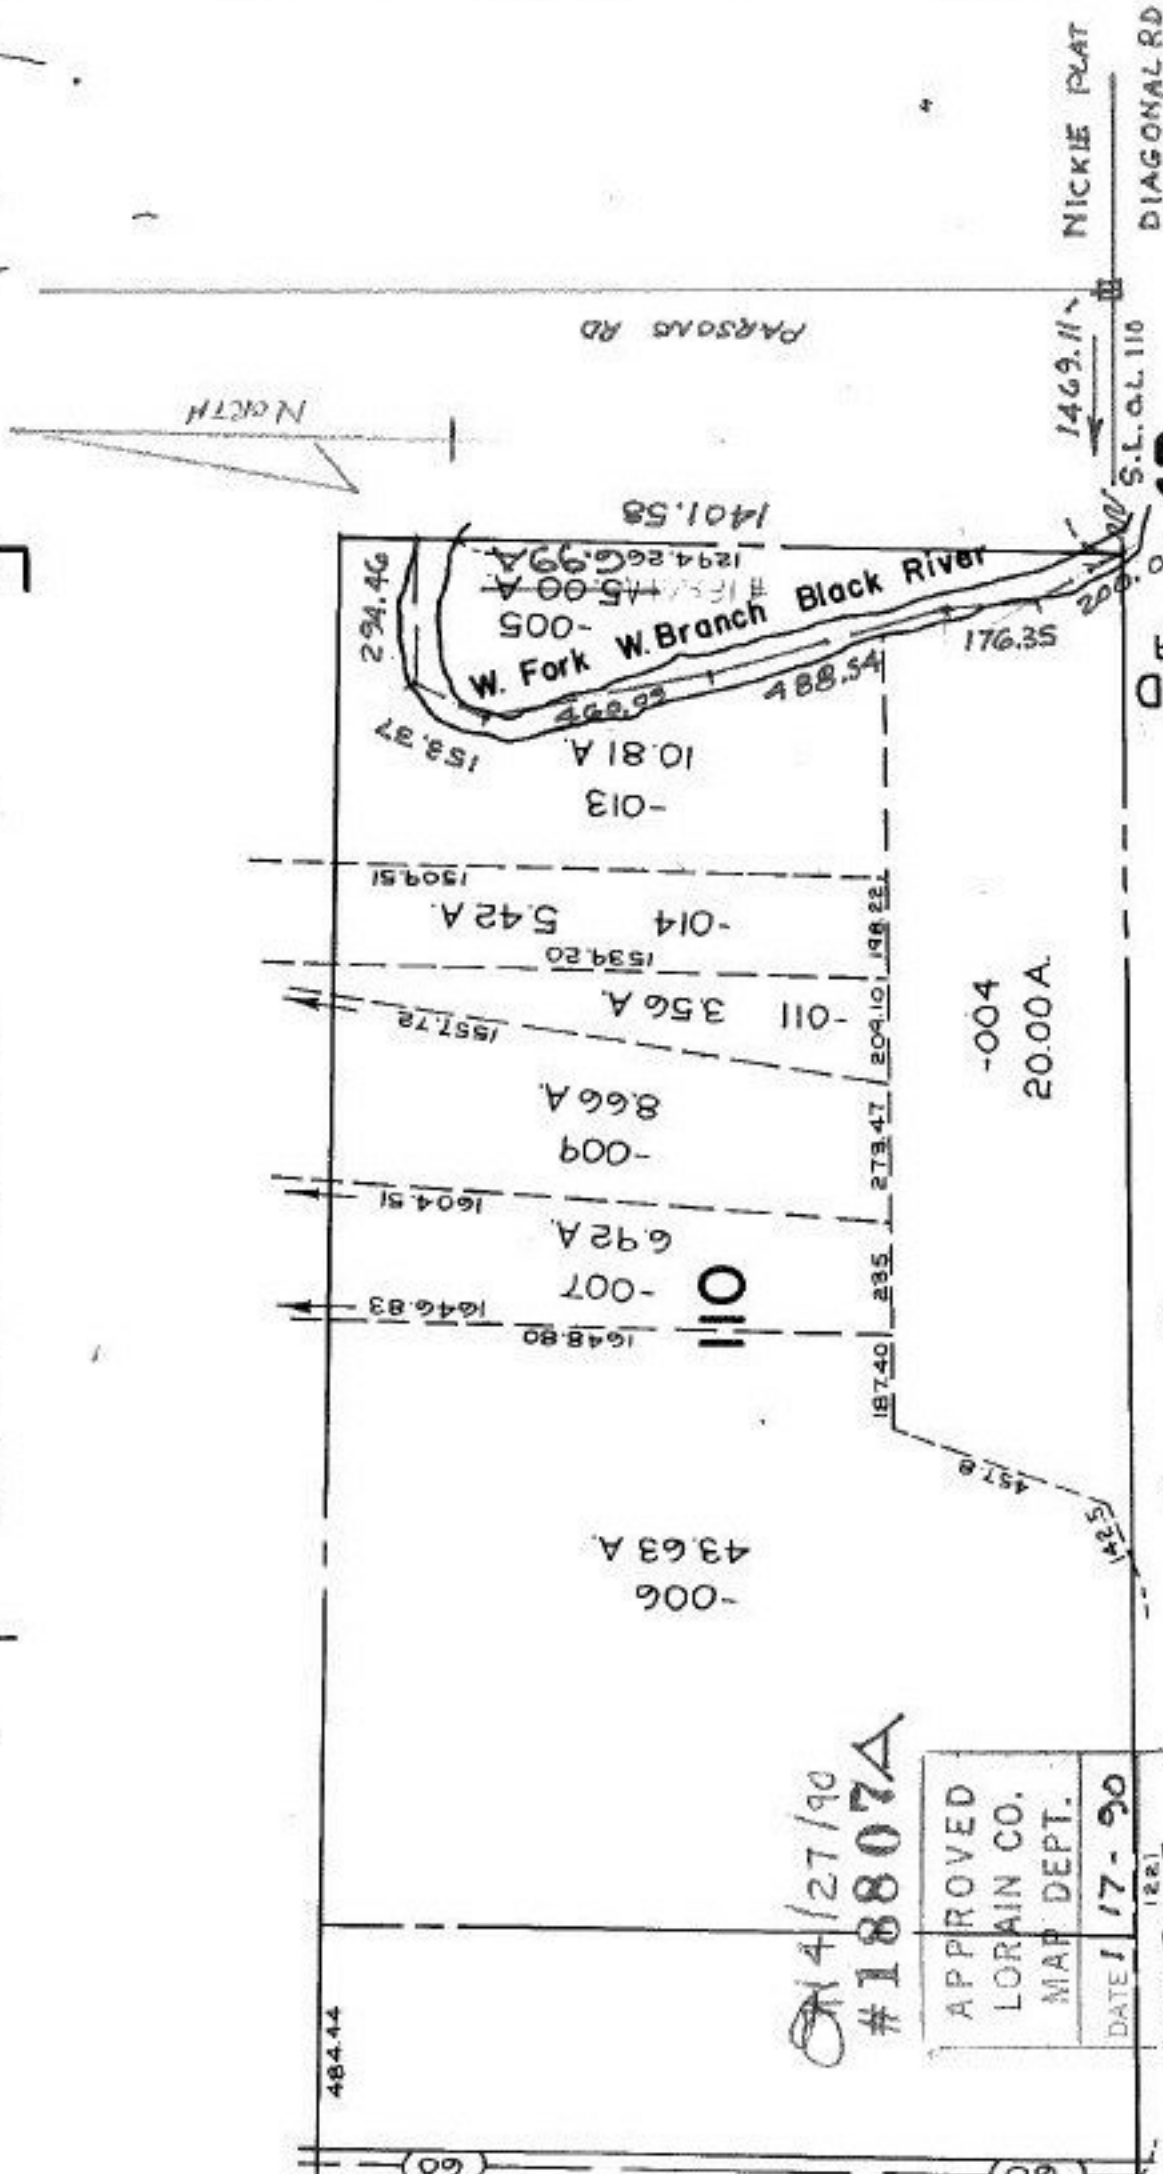


96
96
LOTS

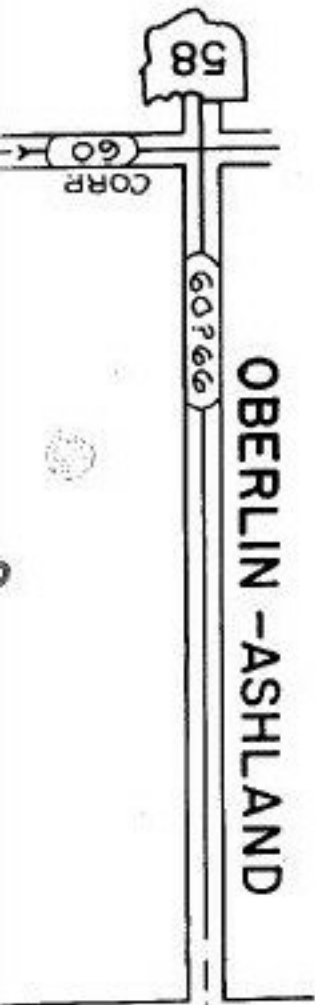

9-6

REVISED
10/4/89

Ac. CORR
09-00-110-000-005
C=15500,000.

ON 4/27/90
#18807A

APPROVED LORAIN CO. MAP DEPT.	DATE 17-90
PAGE 9-6	
BY CAROLYN FRANCIS	
VOID AFTER # 18807A	

484.44

60

60