


10-00-005-101-  
C=1: 933, 993.

**AUBURN**

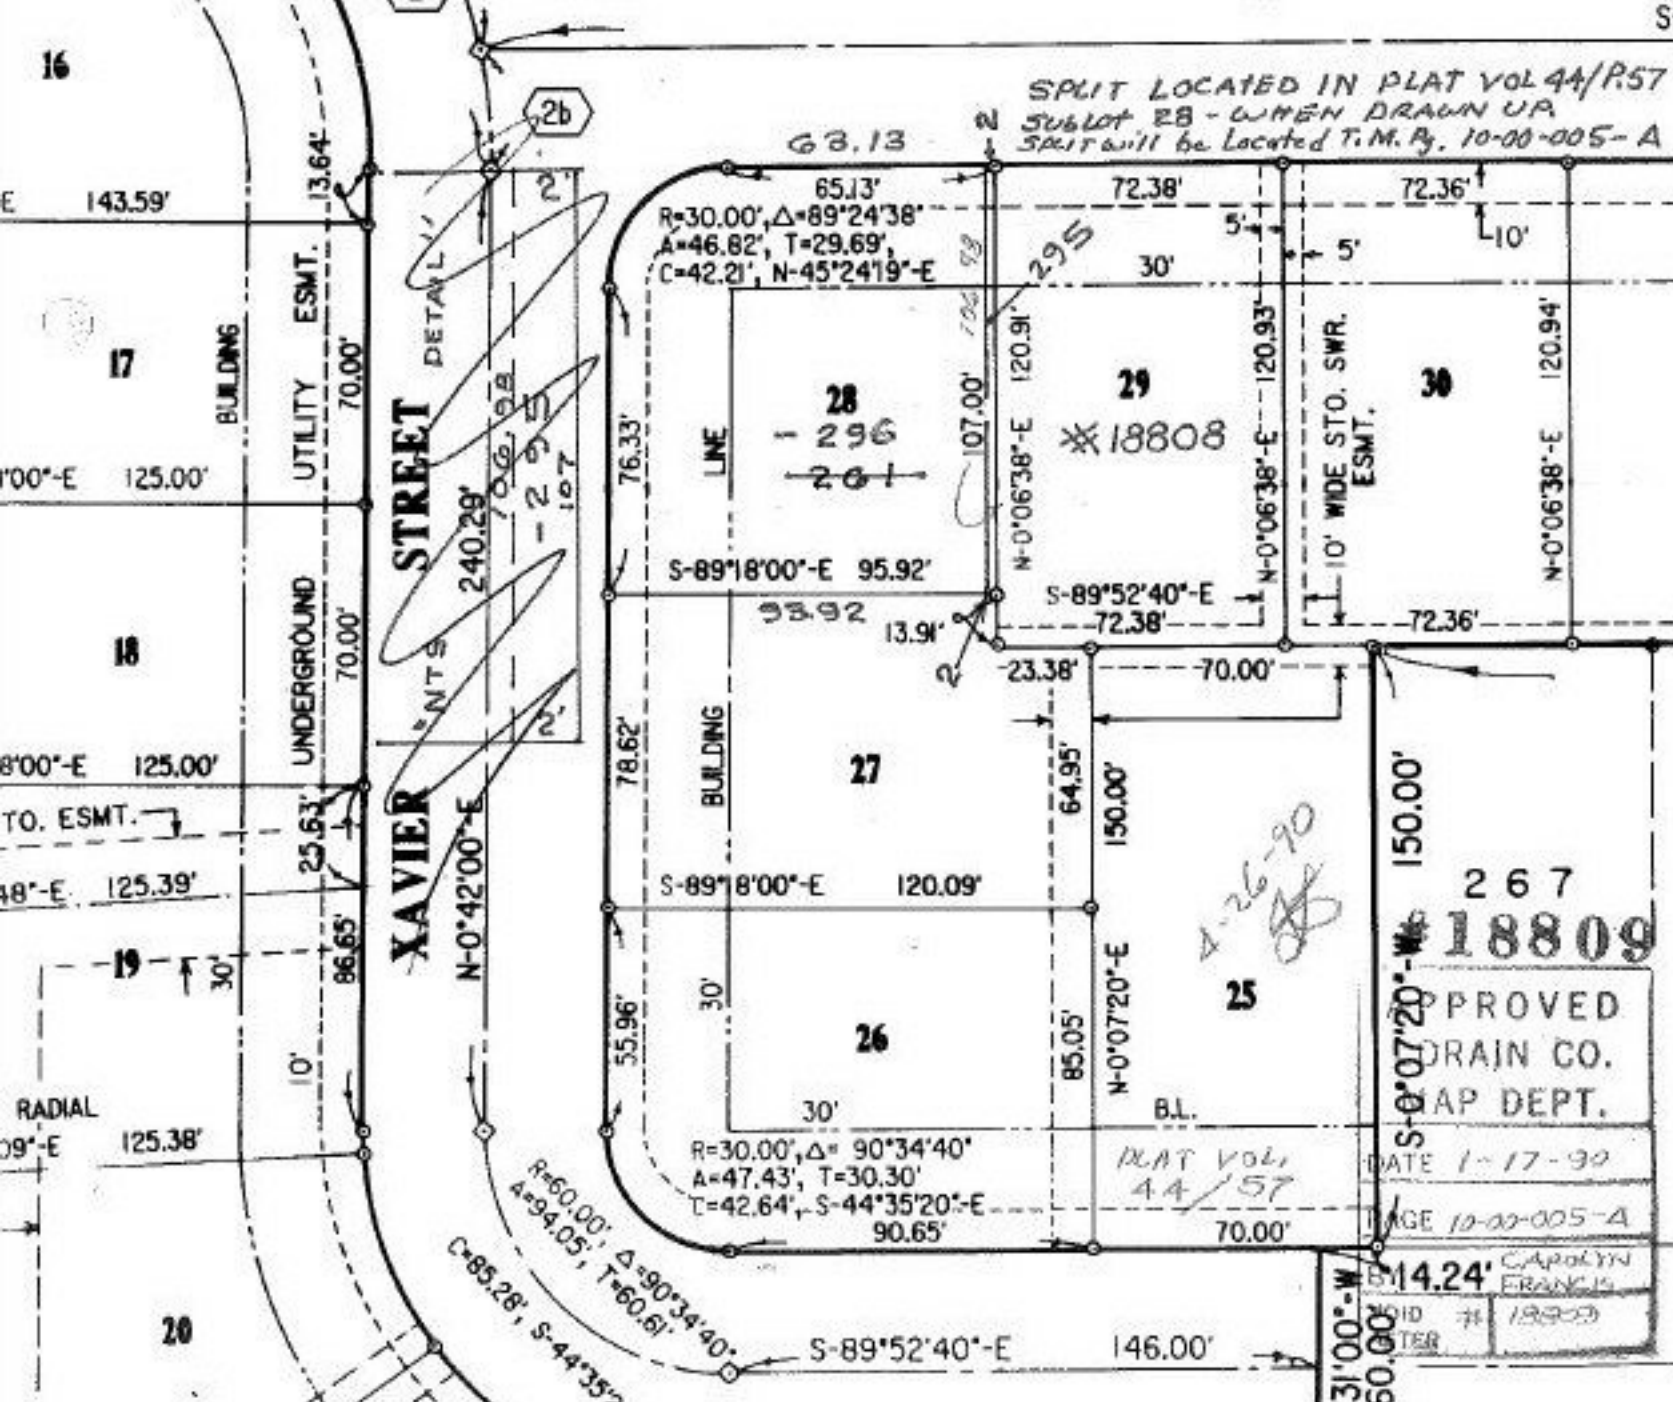

SPLIT LOCATED IN PLAT VOL 44/R57  
SUBLOT 28 - WHEN DRAWN UP  
SPLIT will be Located T.M. Pg. 10-00-005-A

65.13  
R=30.00', Δ=89°24'38"  
A=46.82', T=29.69'  
C=42.21', N-45°24'19"-E

S-89°18'00"-E 95.92'

S-89°18'00"-E 120.09'

R=30.00', Δ=90°34'40"  
A=47.43', T=30.30'  
C=42.64', S-44°35'20"-E  
90.65'

S-89°52'40"-E 146.00'

267  
**18809**

APPROVED  
DRAIN CO.  
CAP DEPT.

DATE 1-17-90

PAGE 10-00-005-A

BY 14.24' CAROLYN FRANCIS

VOID # 18809

*4-26-90*

PLAT VOL 44/57

31'00"-W  
60.00'