


SR 32  
ROYALTON Rd  
1418.66 088

HGN

82

RD.

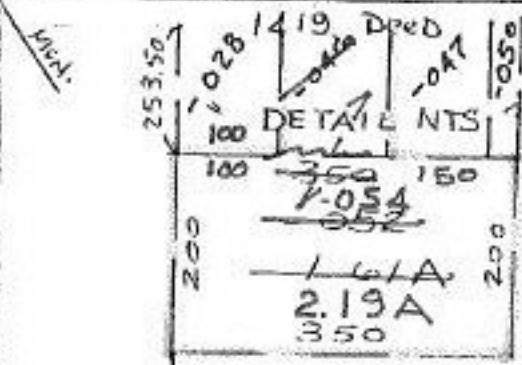

RD.

32 Rds.  
-035  
2.00 A.  
10 Rds.

1.61A-052  
0.58A-046  
2.19A Comb. A

SEE 11-00-005-A

-051 76.90  
SUIT 76.91  
REM: 1.61  
75.30

-053  
-051  
76.90 A  
76.91 A PER REG.  
75.30 A

COWLEY RD


5

COMBINATION

10-00-005-000-046, 052

4/27/90  
#18810A

11-00-005-000- prior inst. 905/956  
SURVEYED BY: GILBERT NELSON REG. SURV.  
C=1:INF.

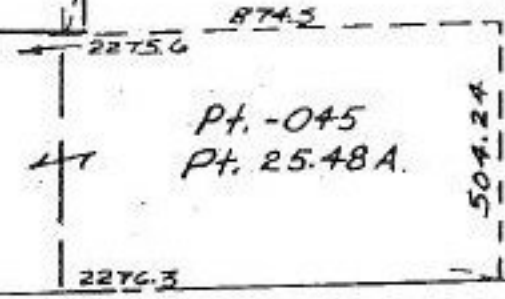

-001  
25.00 A.

-002  
22.64 A.

2659

APPROVED LORAIN CO. MAP DEPT.	
DATE 1-22-90	
PAGE 11-H	
BY CAROLYN FRANCIS	
VOID AFTER #	18810-A
[REDACTED]	
[REDACTED]	
70