


-013
9.52 A.

-013
~~19.52 A~~
19.52 A

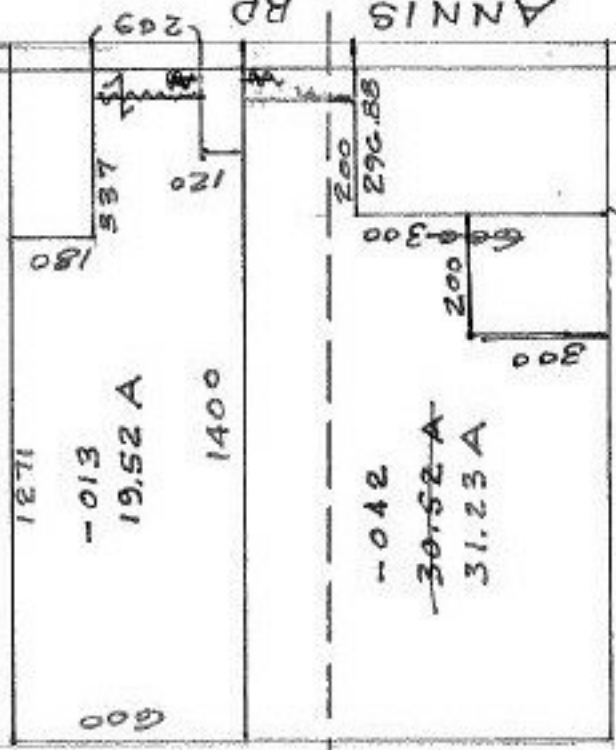

MAP CORRECTION

AC. IS OK - TAKE OUT
HOOK - PER DV. OR 7/52
783/703

ADD DISTANCES
PER DV. OR 7/52

200
-014 8
0.28 A.
-015 9
0.28 A.
200

30.52 A
1.60 A
32.12 A
-0.89 A
31.23 A

09-00-004-101-

MAP §
AC. CORR.
4/27/90
#18824A

APPROVED
LORAIN CO.
MAP. DEPT.
DATE 2-5-90
PAGE 9-00-004 A
BY CAROLYN FRANCIS
VOID AFTER # 18824A

-042
~~30.52 A~~
31.23 A

AC. CALC by TAX MAP
DEPT.
-025 1.60 A CORRECTED
To. 0.89 Ac.

-042 - 30.52 A CORRECTED
To. 31.23 A
DV. 3/927

MAP § AC. CORR.
PER DEED RESEARCH
§ AC. CALC. by TAX MAP
DEPT.

200
296.88
-017
0.68 A.

SEE 9-00-0

DEED
RESEARCH
DV. 269/68
327/487
488
724/877
783/521
522
785/601
783/699
789/701
783/703
783/705
784/627
784/629
784/627
785/112
785/114
801/386
801/888
8207/428
979/678
OR 7/522
OR 3/927

042
52 A.