


LOGAN

-006  
4.00A.

06-25-006-113- PRIOR INST. OR.135/316  
1339/873  
EAST BROAD ST PLAT C-11700,000,  
STORM SEWER Pg 9 & 12

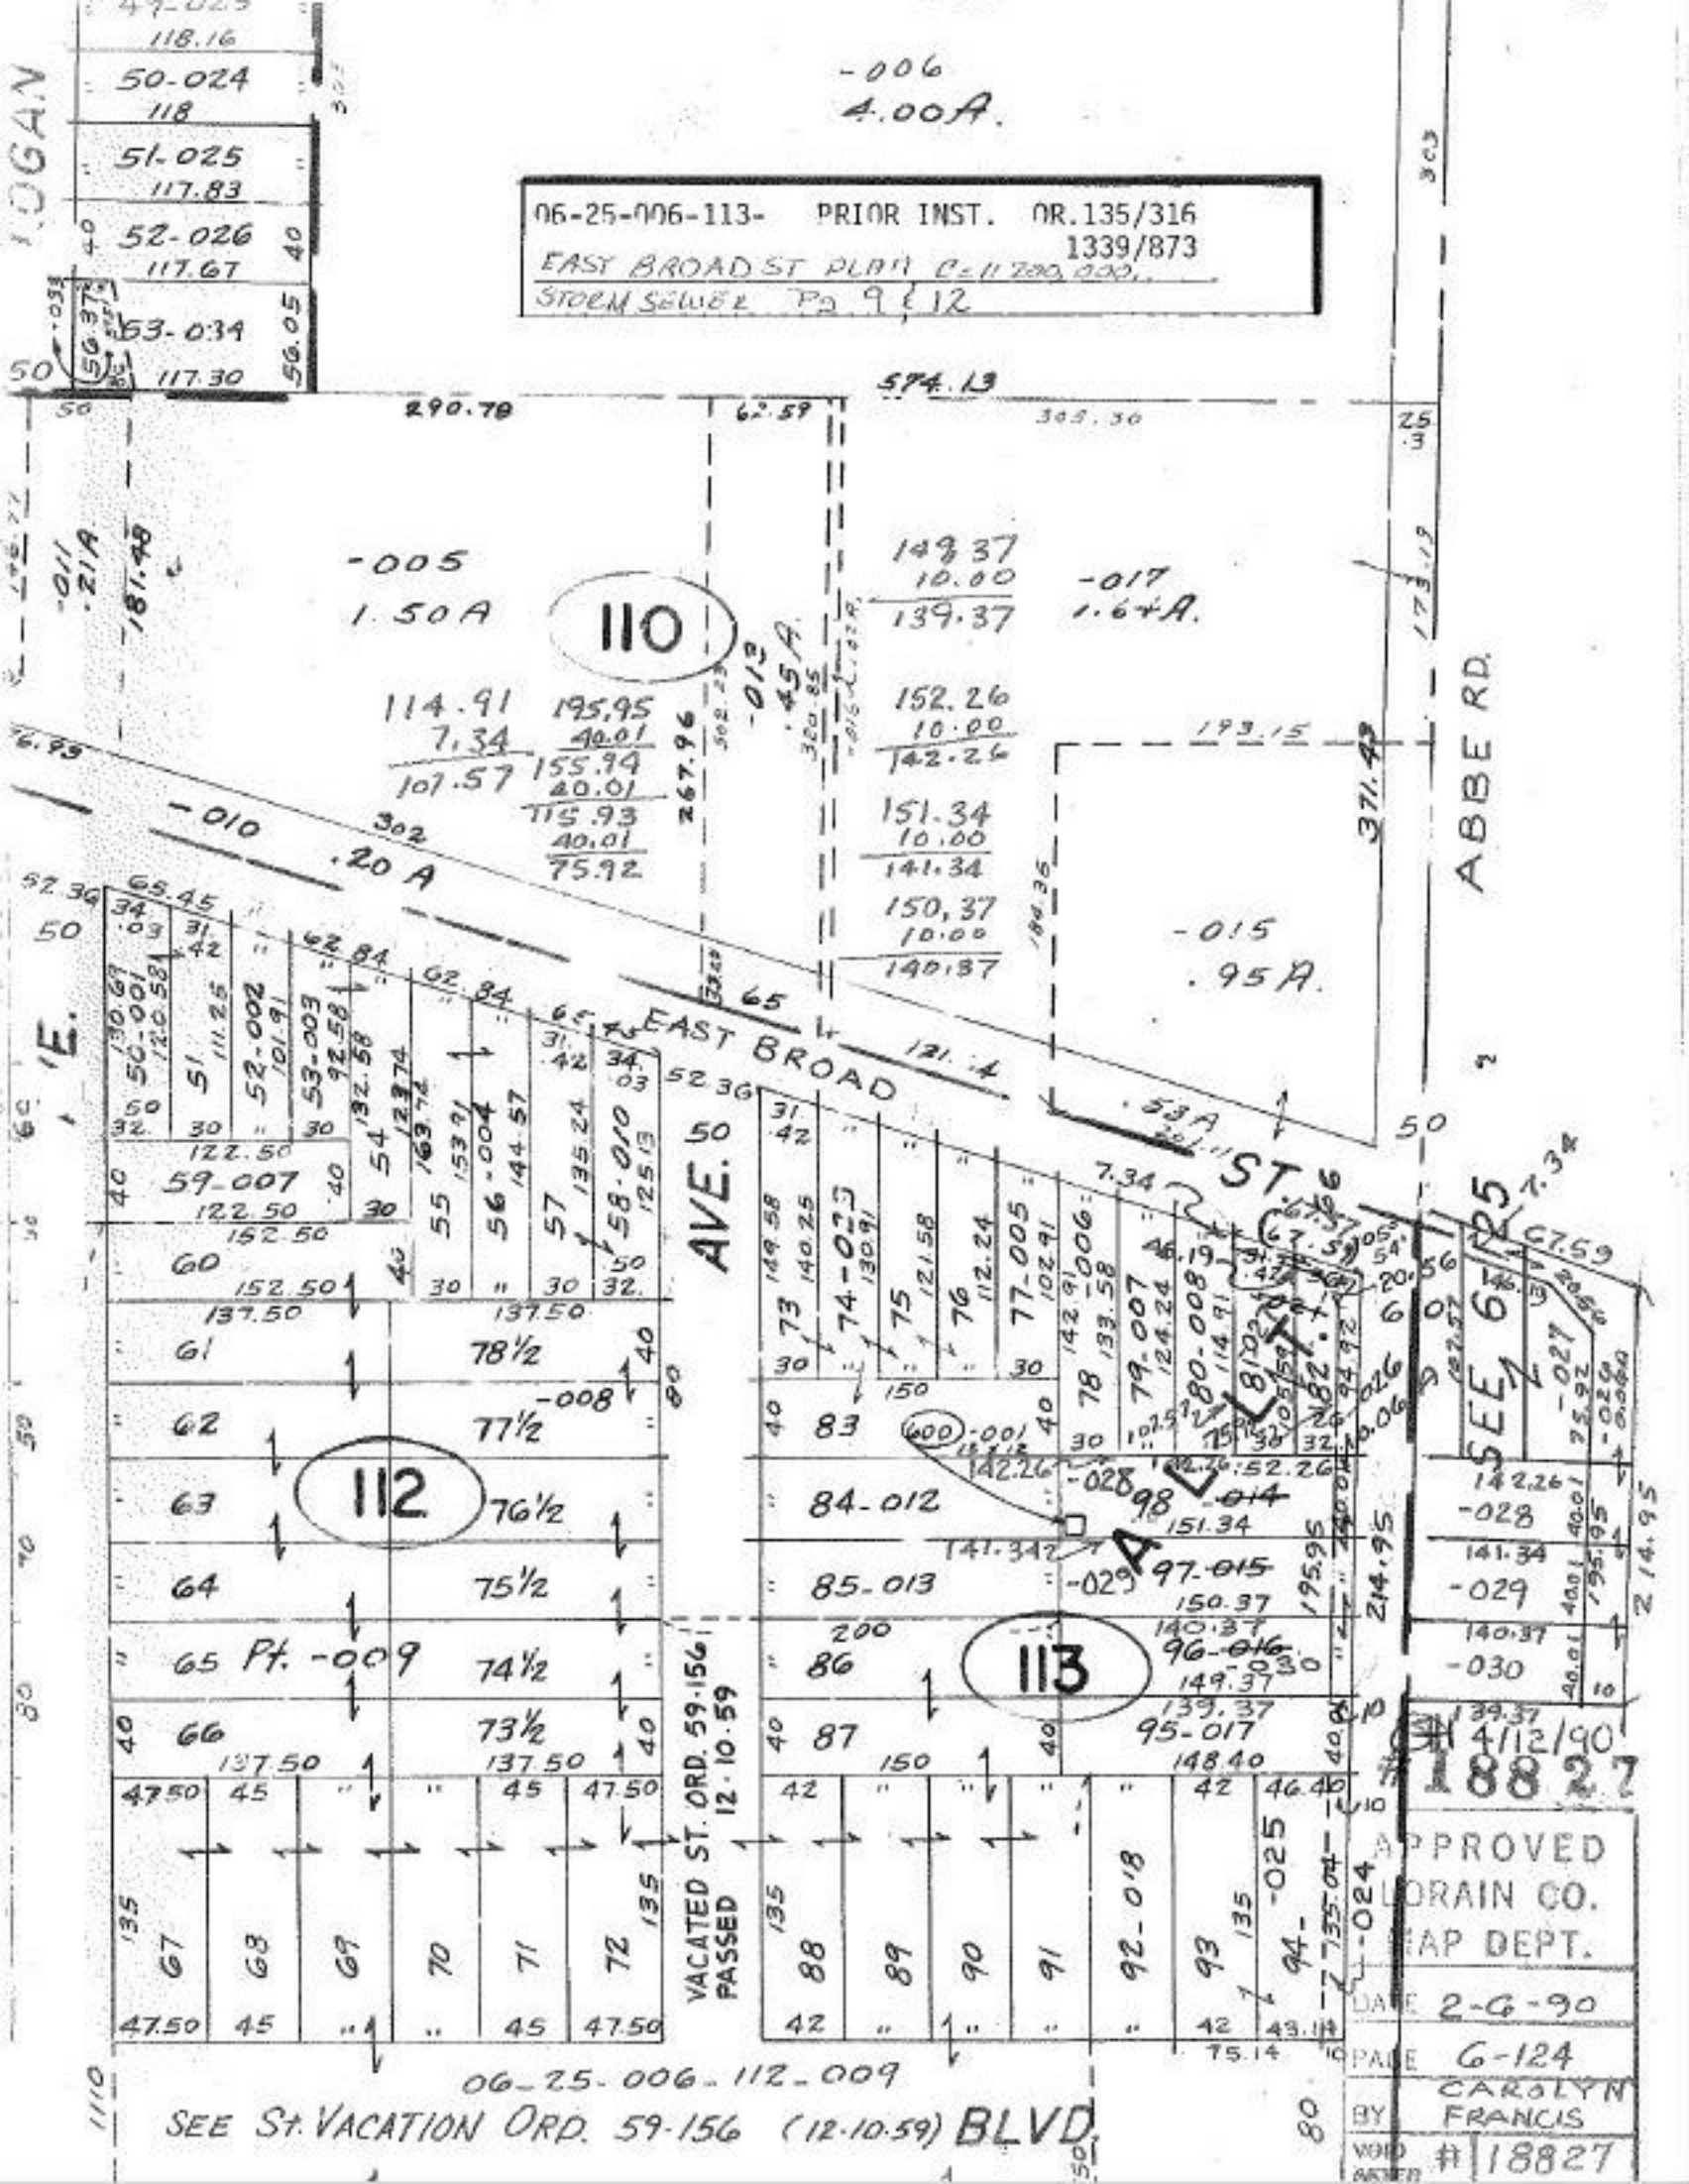

47-023  
118.16  
50-024  
118  
51-025  
117.83  
52-026  
117.67  
53-034  
117.30

-005  
1.50A

110

149.37  
10.00  
139.37

-017  
1.64A.

114.91 195.95  
7.34 40.01  
101.57 155.94  
115.93 40.01  
75.92

152.26  
10.00  
142.26

151.34  
10.00  
141.34

150.37  
10.00  
140.37

-015  
.95A.

59-007  
59-008  
59-009  
60  
61  
62  
63  
64  
65 Pt.  
66  
67  
68  
69  
70  
71  
72

112

113

AVE. 50

VACATED ST. ORD. 59-156  
PASSED 12-10-59

ABBE RD.

SEE 67-125

4/12/90  
18827

APPROVED  
DRAIN CO.  
SEAP DEPT.

DATE 2-6-90

PAGE 6-124

BY CAROLYN FRANCIS

NO. # 18827

06-25-006-112-009  
SEE ST. VACATION ORD. 59-156 (12-10-59) BLVD.