


SEE 11-00-028-A

0 4 DYE 346.65 1038.65 346 1038.65

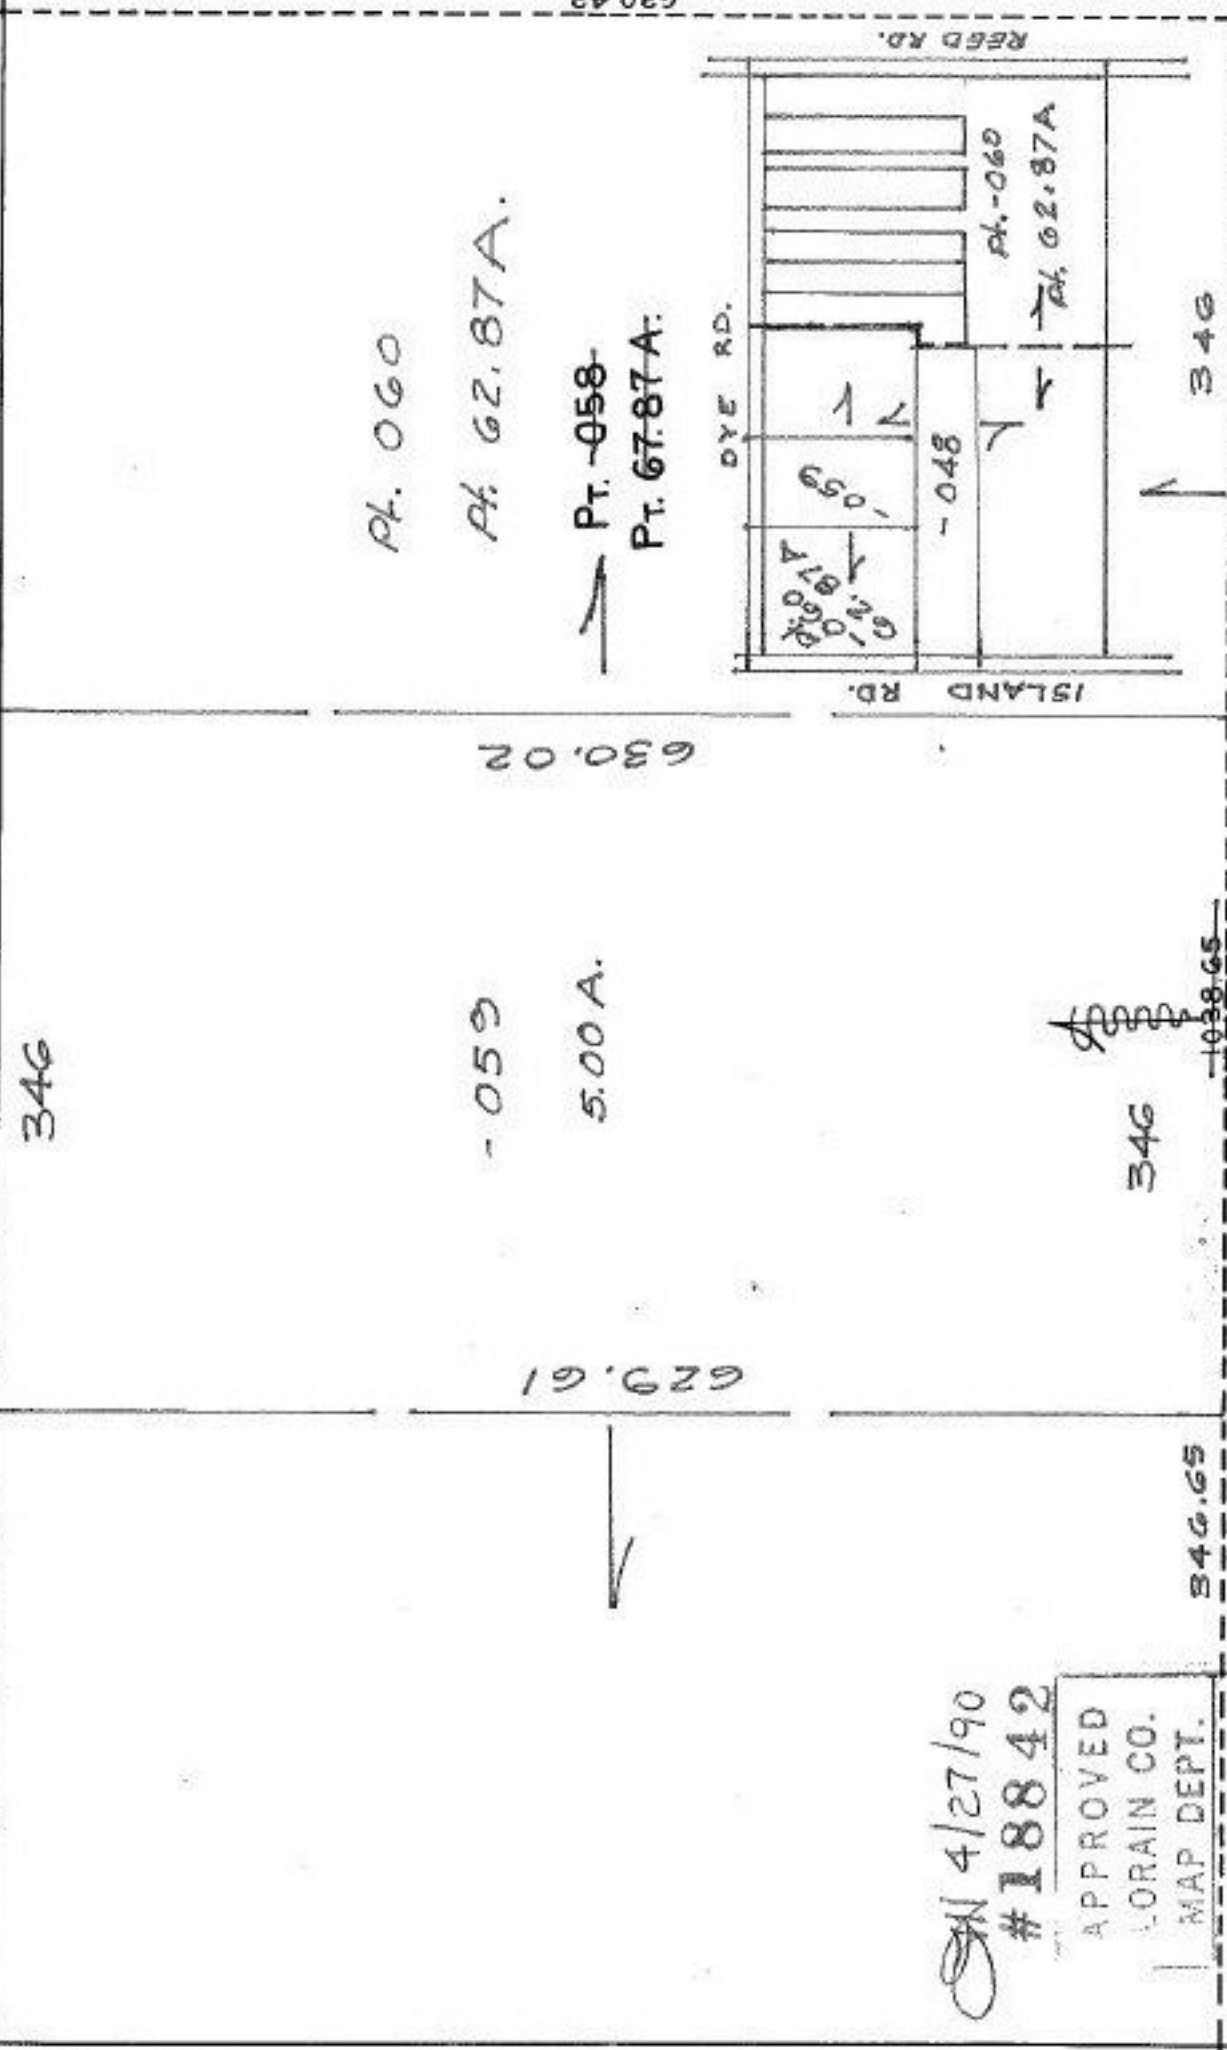

SW 4/27/90
#18842

APPROVED
LORAIN CO.
MAP DEPT.

DATE 2-8-90

PAGE 11-00-028A

BY CAROLYN
FRANCIS

VOID AFTER # 18842

11-00-028-000- PRIOR INST. OR. 73/43 C=1:250,000.
SURVEYED BY: JOHN POZYMAK REGISTER SURVEYOR