


40.00A.

21-17-007-000- PRIOR INST. OR.242/395
SURVEYED BY: JOHN R. HAMILTON REG. SURV.
C=1:1,000,000.

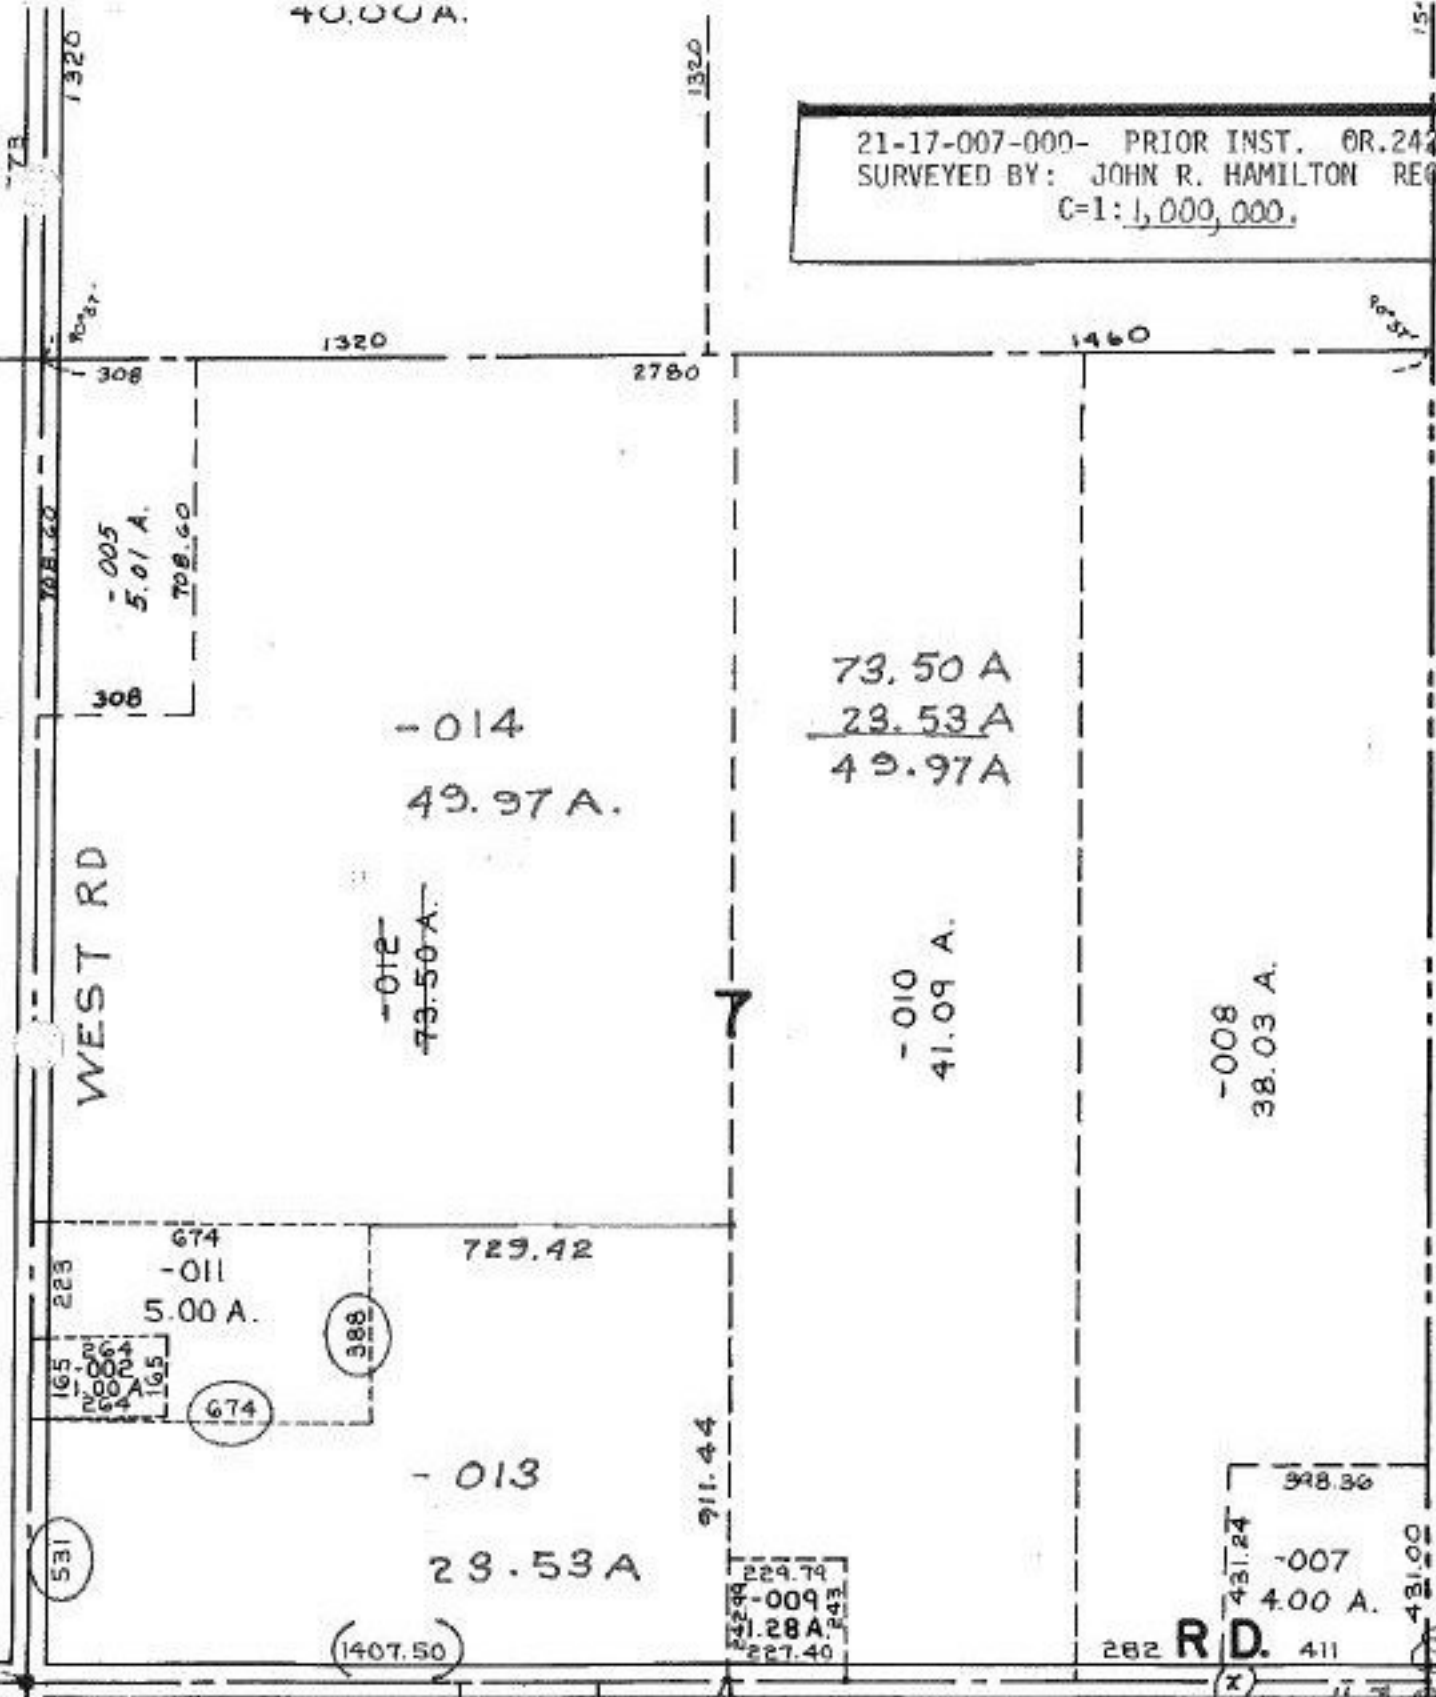

WEST RD

BURSLEY RD

R.D. 411

4/24/90
#18847

APPROVED
LORAIN CO.
MAP DEPT.

DATE 2-16-90

PAGE 21-D

BY CAROLYN FRANCIS

VOID AFTER #18847

B