


145

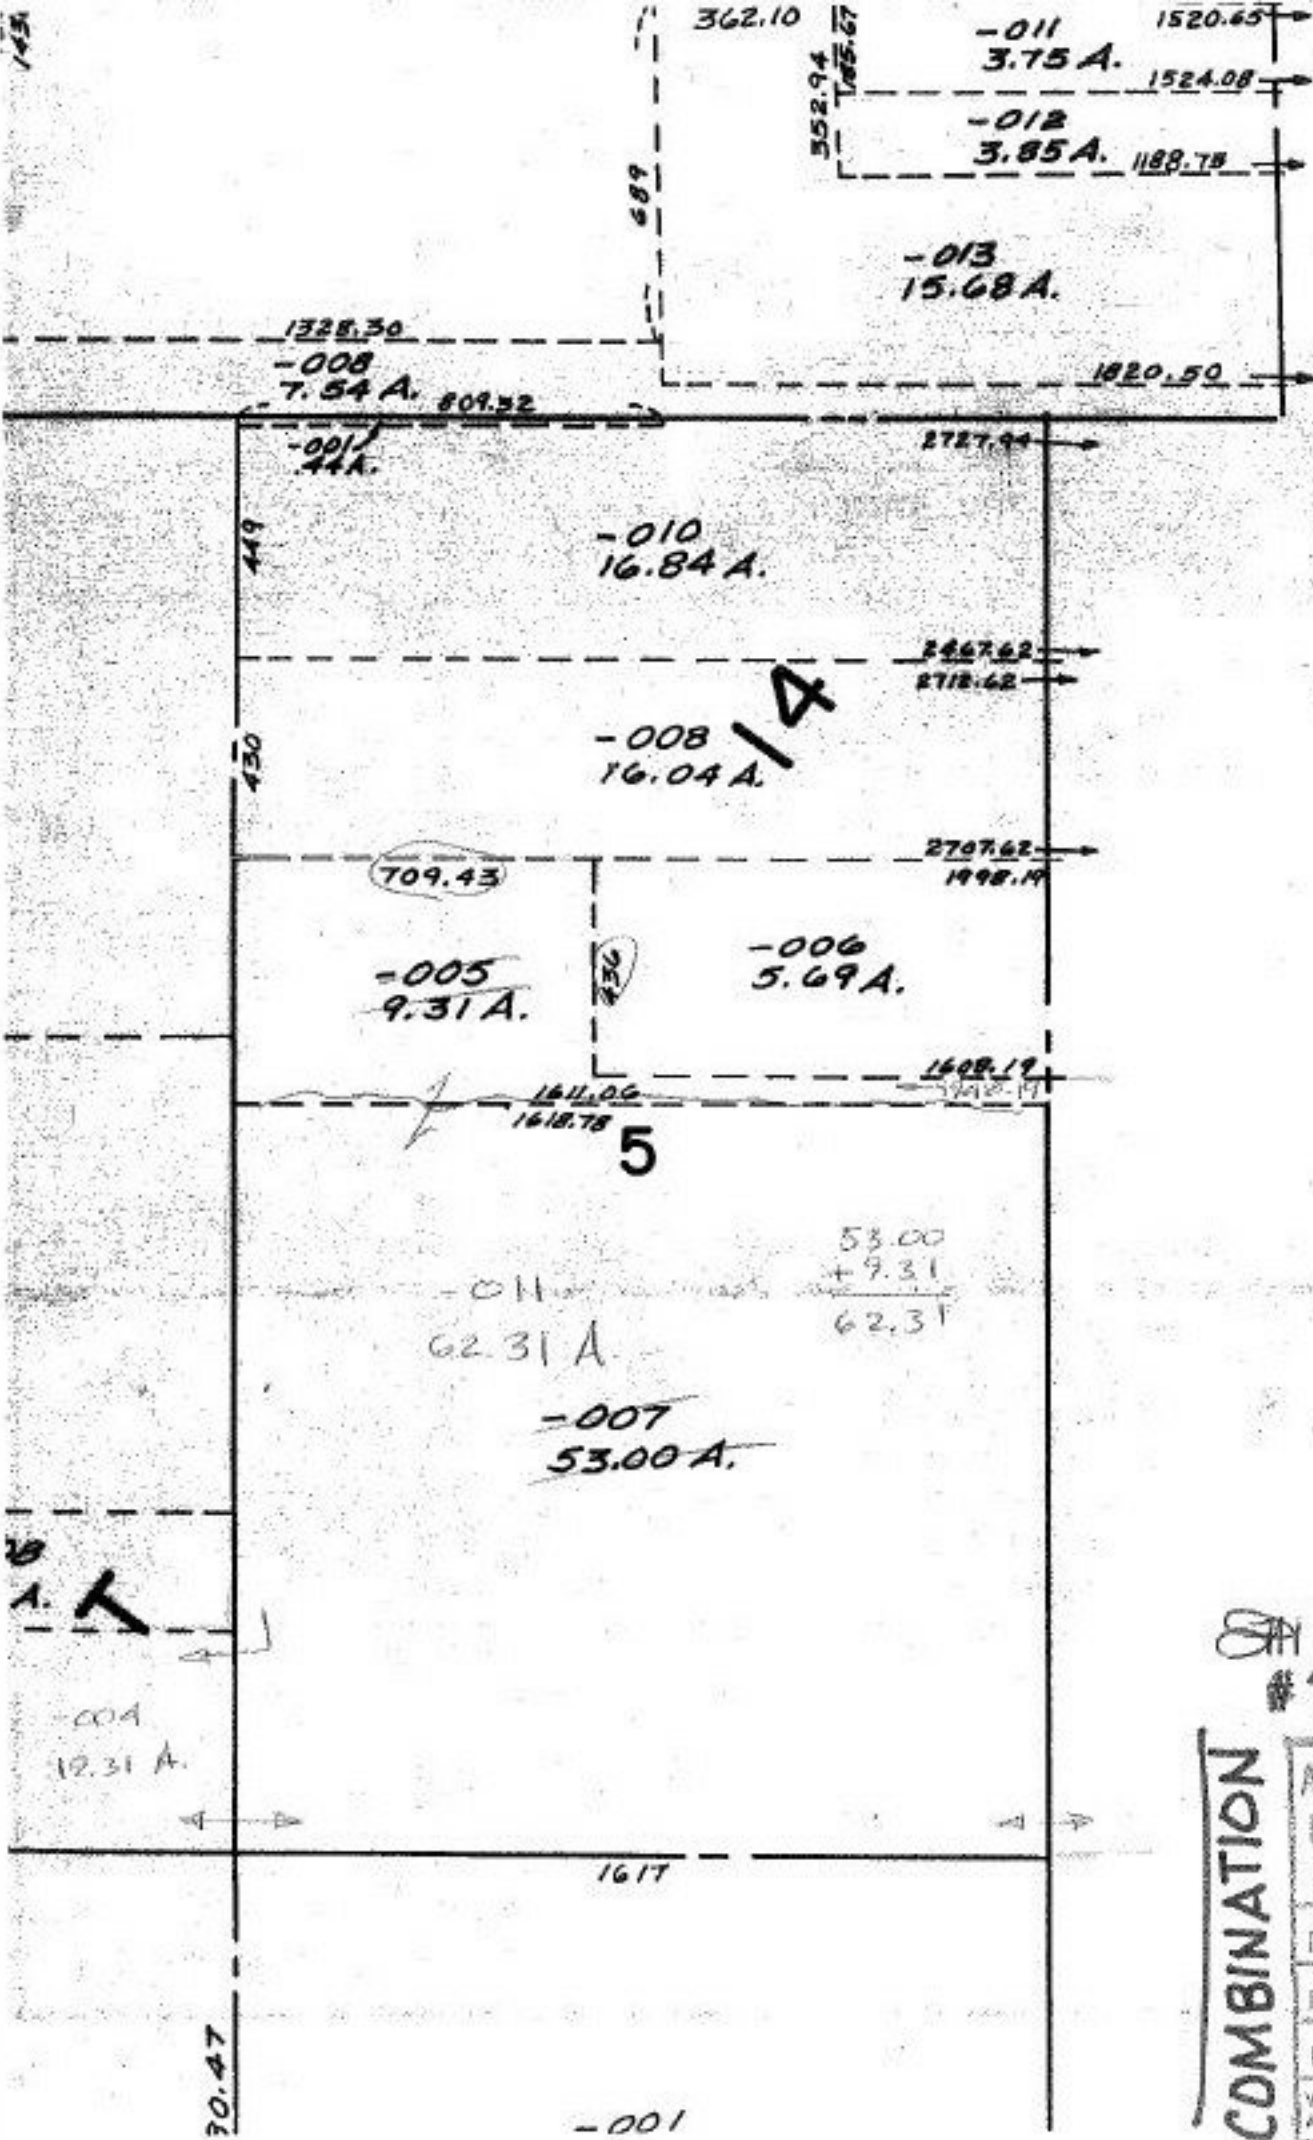

5/7/90
#18855-A

COMBINATION

APPROVED	
LORAIN CO.	
MAP DEPT.	
DATE 4-13-90	
PAGE 8-B	
BY T. McNamee	
VOID AFTER	18855-A