



1716.11  
1714.59  
1848  
1429.54

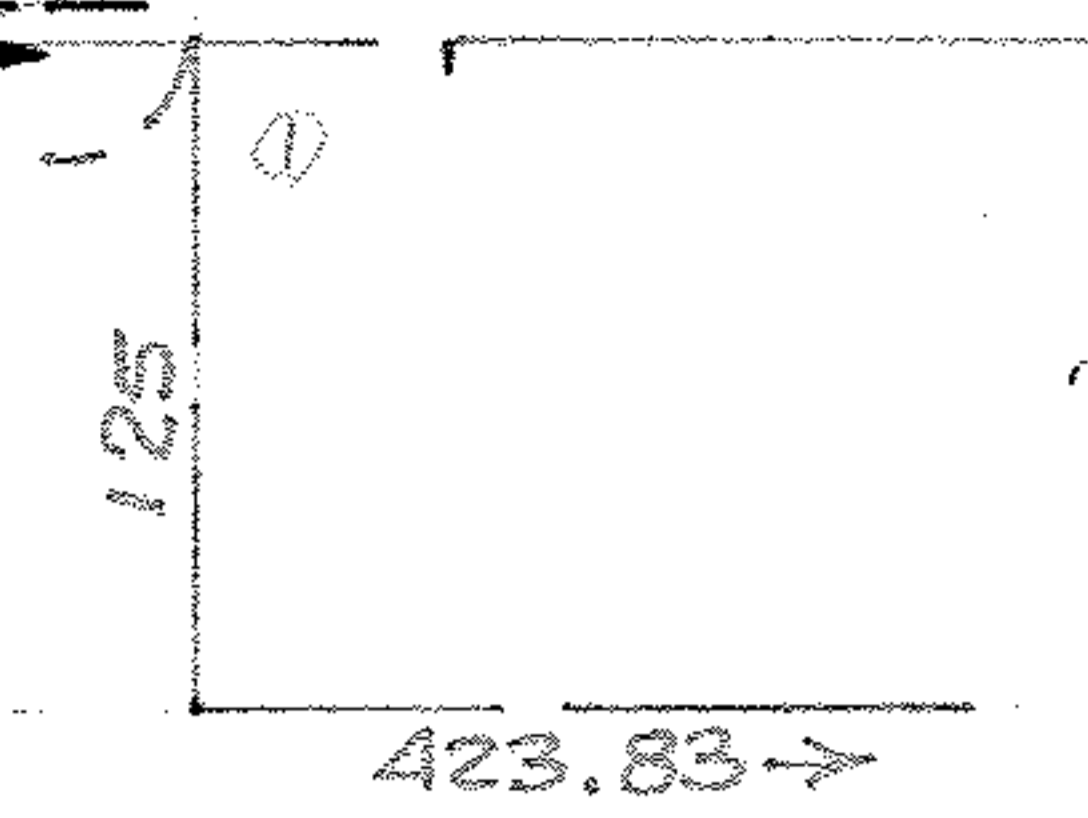

pt. - 056  
pt. 7.98 A.

1346.96

952.83

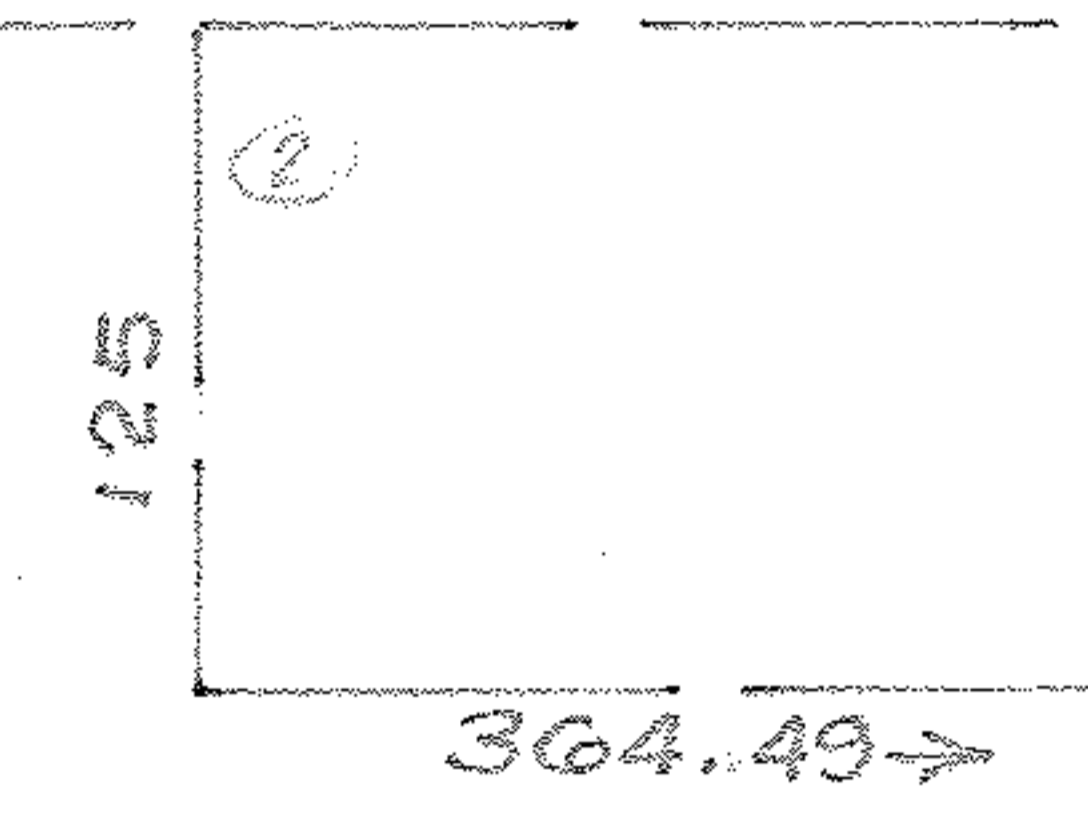

pt. 057 #18814  
pt. 5.69 A Pt. -010  
Pt. 23.12 A.

12-00-038-000- PRIOR INST. OR. 249/332  
(1) C=1:35,714 (2) C=1:250,000. (3) C=1:30303.  
(4) C=1:15,625. (5) 1:100,000  
SURVEYED BY: GILES NELSON REG. SURVEYOR

-010 23.12 A  
SPLIT (1) 1.26 A  
-011 21.86 A  
15.36 A. SPLIT @ 1.09 A  
20.77 A  
SPLIT (3) 7.98 A  
12.79 A  
SPLIT (4) 5.69 A  
7.10 A

1023.64  
1023.64  
(REM!)

pt. - 058  
~~7.10 A~~  
7.73 A. 7.50 A  
Ac. CORE. PER SURVEY  
by Giles Nelson  
Reg. Surveyor

827.91

4/24/90  
#18874  
APPROVED  
LORAIN CO.  
MAP DEPT.  
DATE 3-15-90  
PAGE 12-00-038A  
BY CAROLYN  
FRANCIS  
VOID #18874