
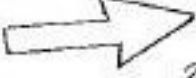


-003  
49.20 A.

# RUSSIA

60

DETAIL (NEAR 7/1 SCALE) 

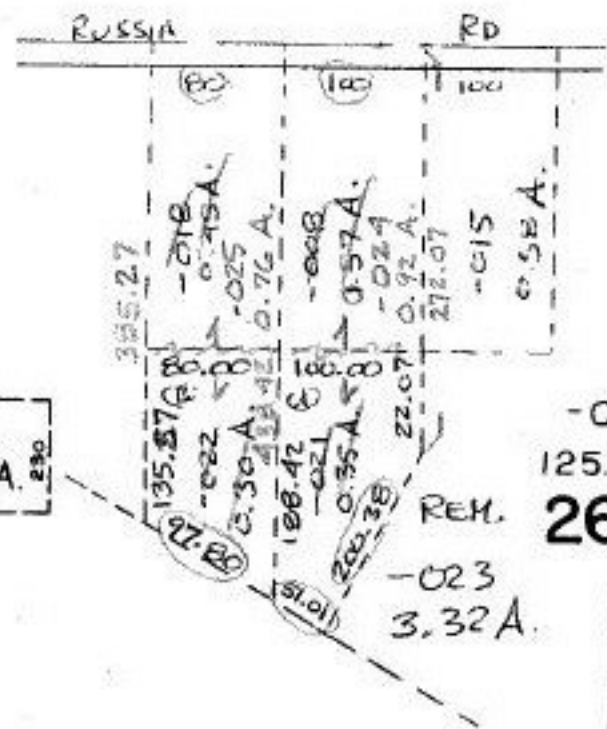

-014  
125.84 A.  
REH. 26

SEE SURVEY MAP BY  
K. SASSOC  
 (A) CL. 1: 83,333  
 (B) CL. 1: 200,000  
 (C) CL. 1: 106,141  
 FROM INST. (D) 1065/852 1406/592

-020  
28.94 A.

-002  
30.56 A.

COMBINATION

4/27/90  
#18887-A

APPROVED	LORAIN CO.
MAP DEPT.	
DATE	3-22-90
PAGE	9-C
BY	T. McInair
VOID AFTER	18887

811.80

234  
-004  
0.80 A.

1098.40

325  
-013  
1.72 A.  
325


175.44  
258  
-007  
0.59 A.  
258  
1.08 A.  
258.02

2800

2557

2778

-003

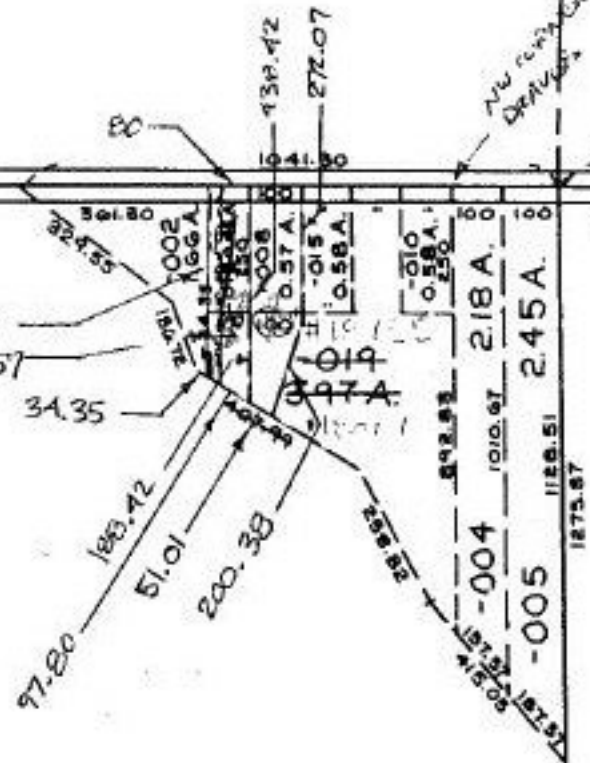

802.06

475

341.65  
-001  
10.00 A.  
341.65