


ACR/AGE CORRECTION PER SURVEY BY  
 K S ASSOC. ET. 1/20/90  
 PRIOR INST.

SEE 5-C

MILAN AVE. ST.

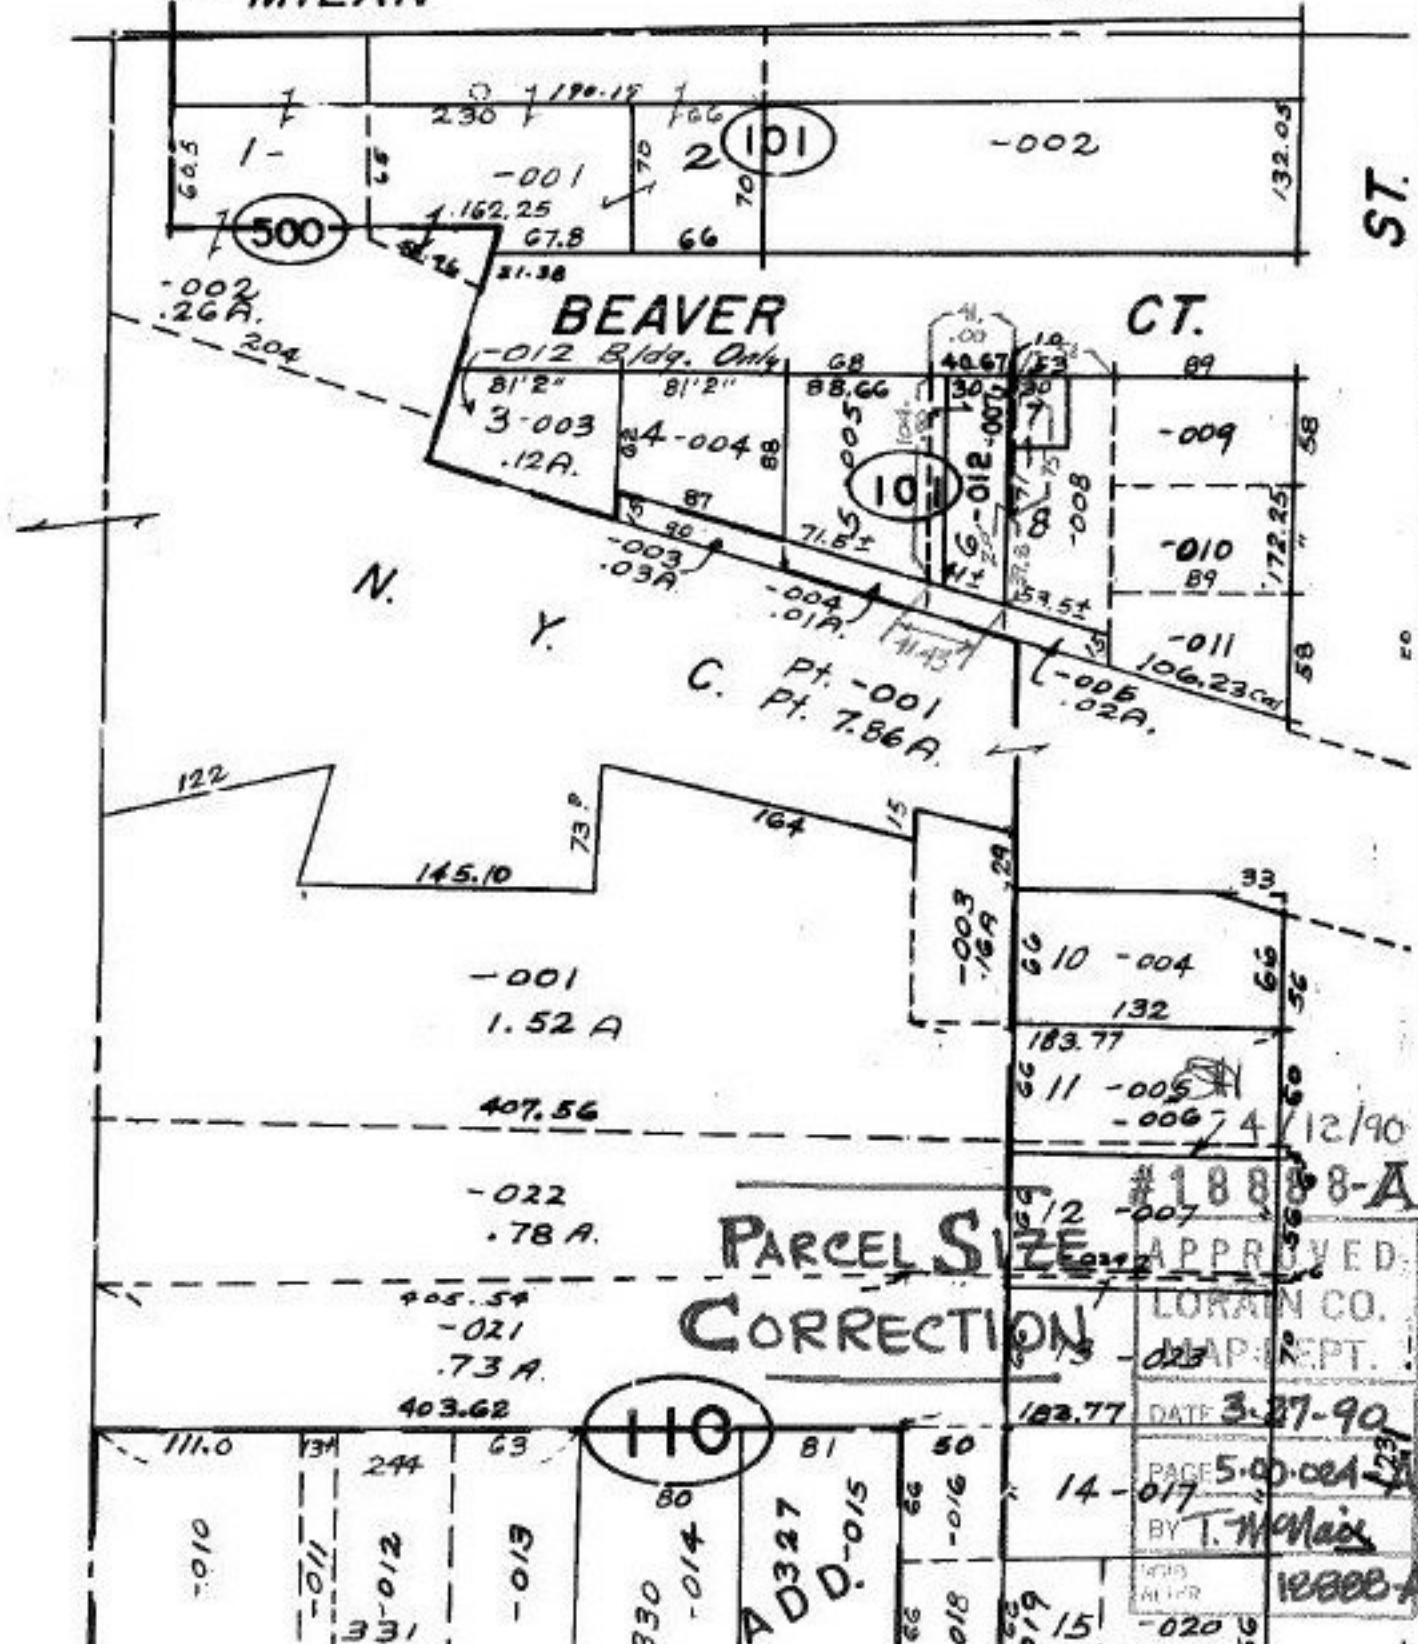

#18888-A  
 APPROVED  
 LORAIN CO.  
 MAP DEPT.  
 DATE 3-27-90  
 PAGE 5-00-001  
 BY T. McNeil  
 18888-A