


Ac. CORR

5/7/90
#18896A

APPROVED
LORAIN CO.
MAP DEPT.
DATE 4-4-90
PAGE 6-50
BY CAROLYN FRANCIS
VOID AFTER #18896A

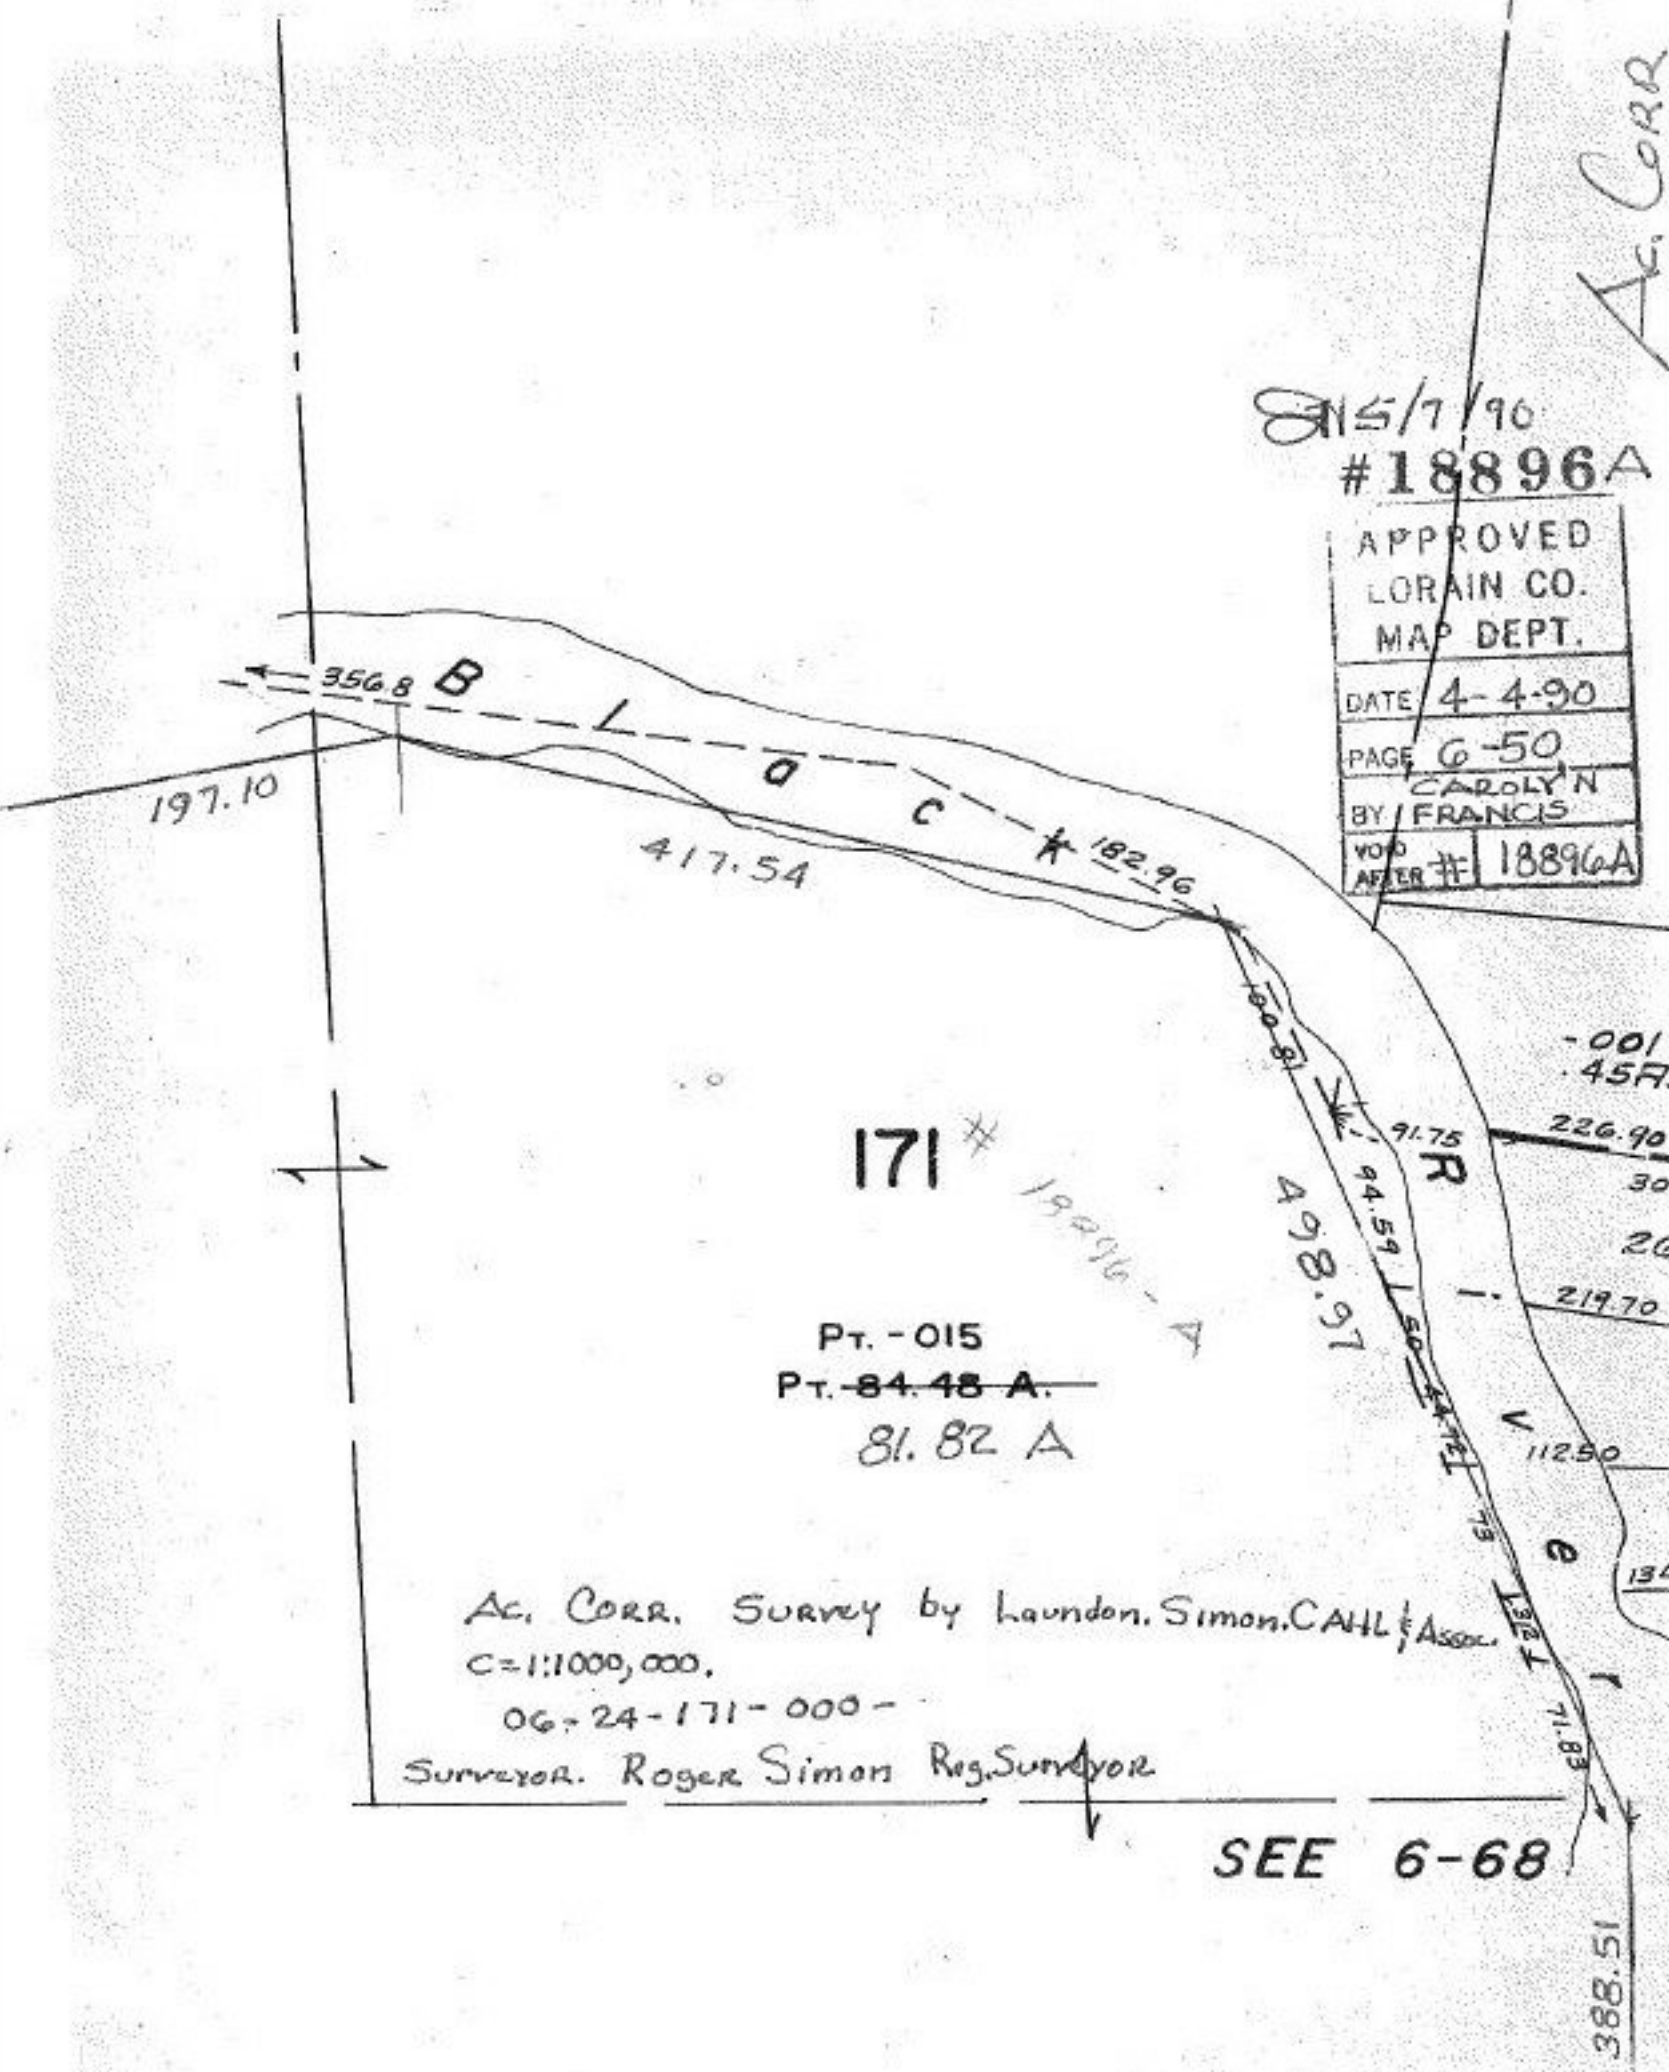

Ac. CORR. Survey by Laundon. Simon, CAHL & Assoc.

C=1:1000,000.

06-24-171-000-

Surveyor. Roger Simon Reg. Surveyor