


X WAS THIS LINE PUT IN BY SURVEY?

LEAVE THIS LINE IN.

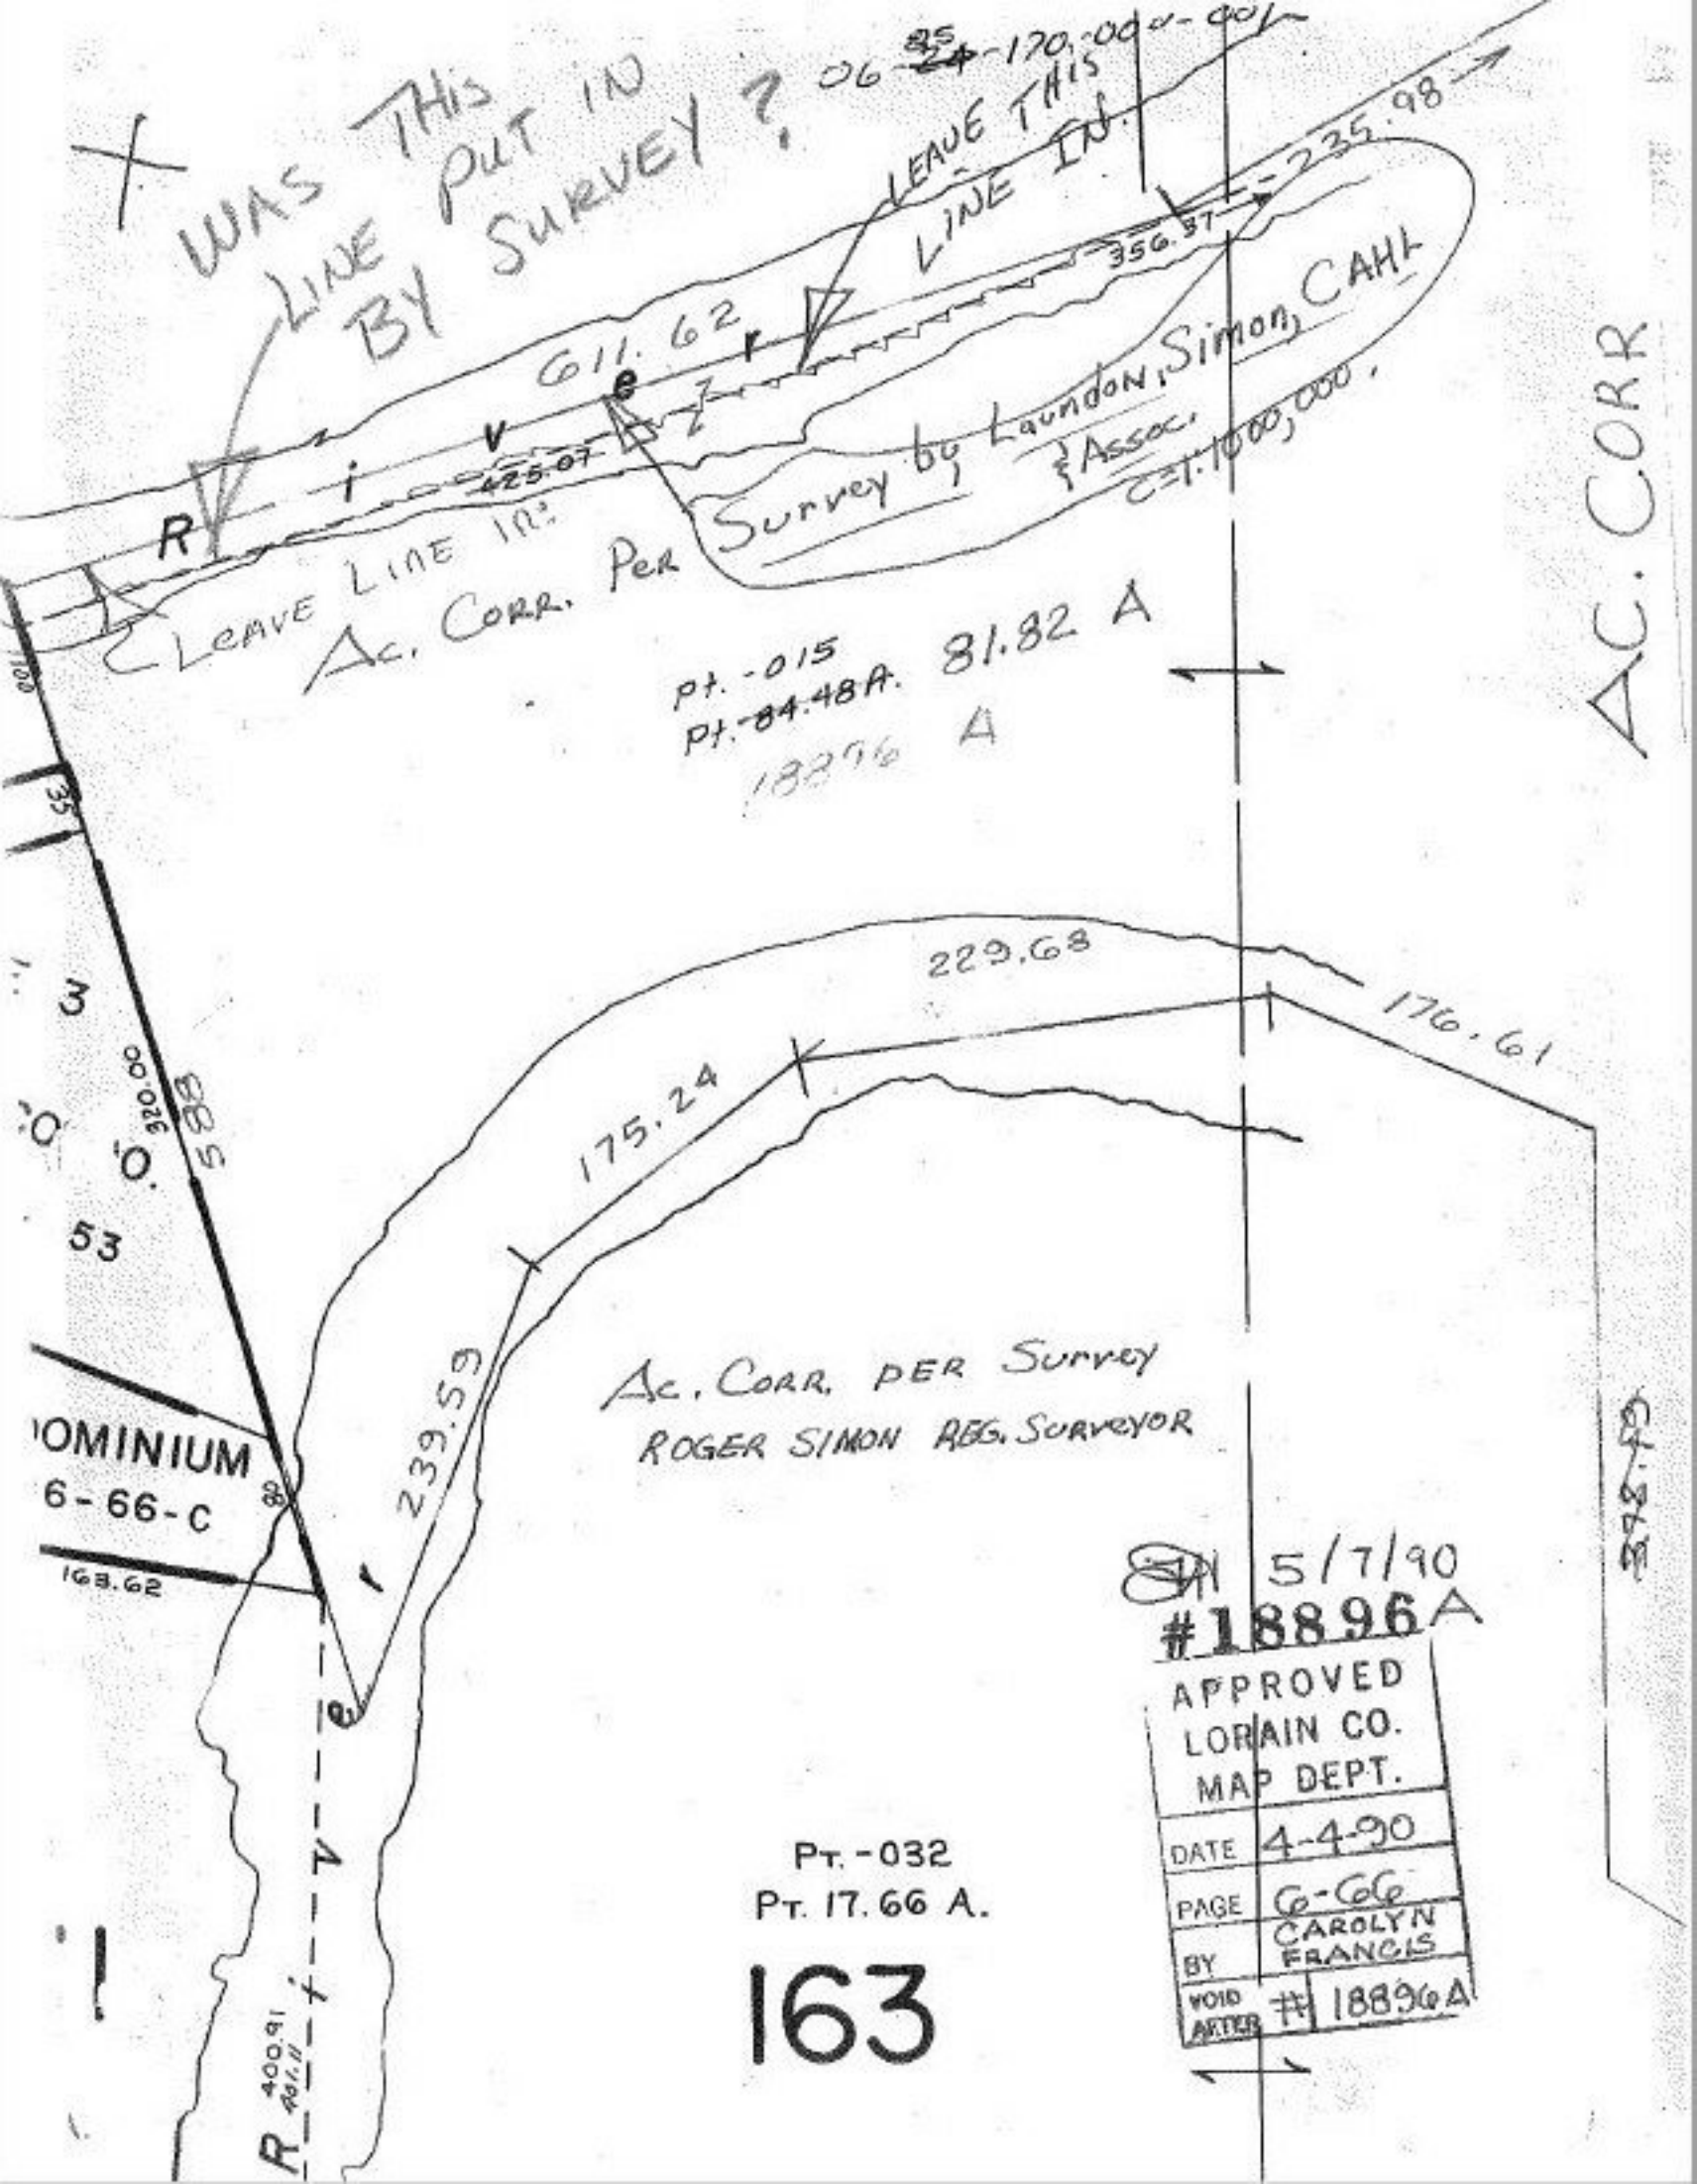

Ac. Corr. Per

Pt. -015 81.82 A
Pt. -84.48 A
18896 A

Ac. Corr. per Survey
ROGER SIMON REG. SURVEYOR

MINIMUM
6-66-C

Pt. -032
Pt. 17.66 A.

163

5/7/90
#18896A

APPROVED
LORAIN CO.
MAP DEPT.
DATE 4-4-90
PAGE 6-66
BY CAROLYN FRANCIS
VOID AFTER #18896A

AC. CORR

67-878