


1862.55

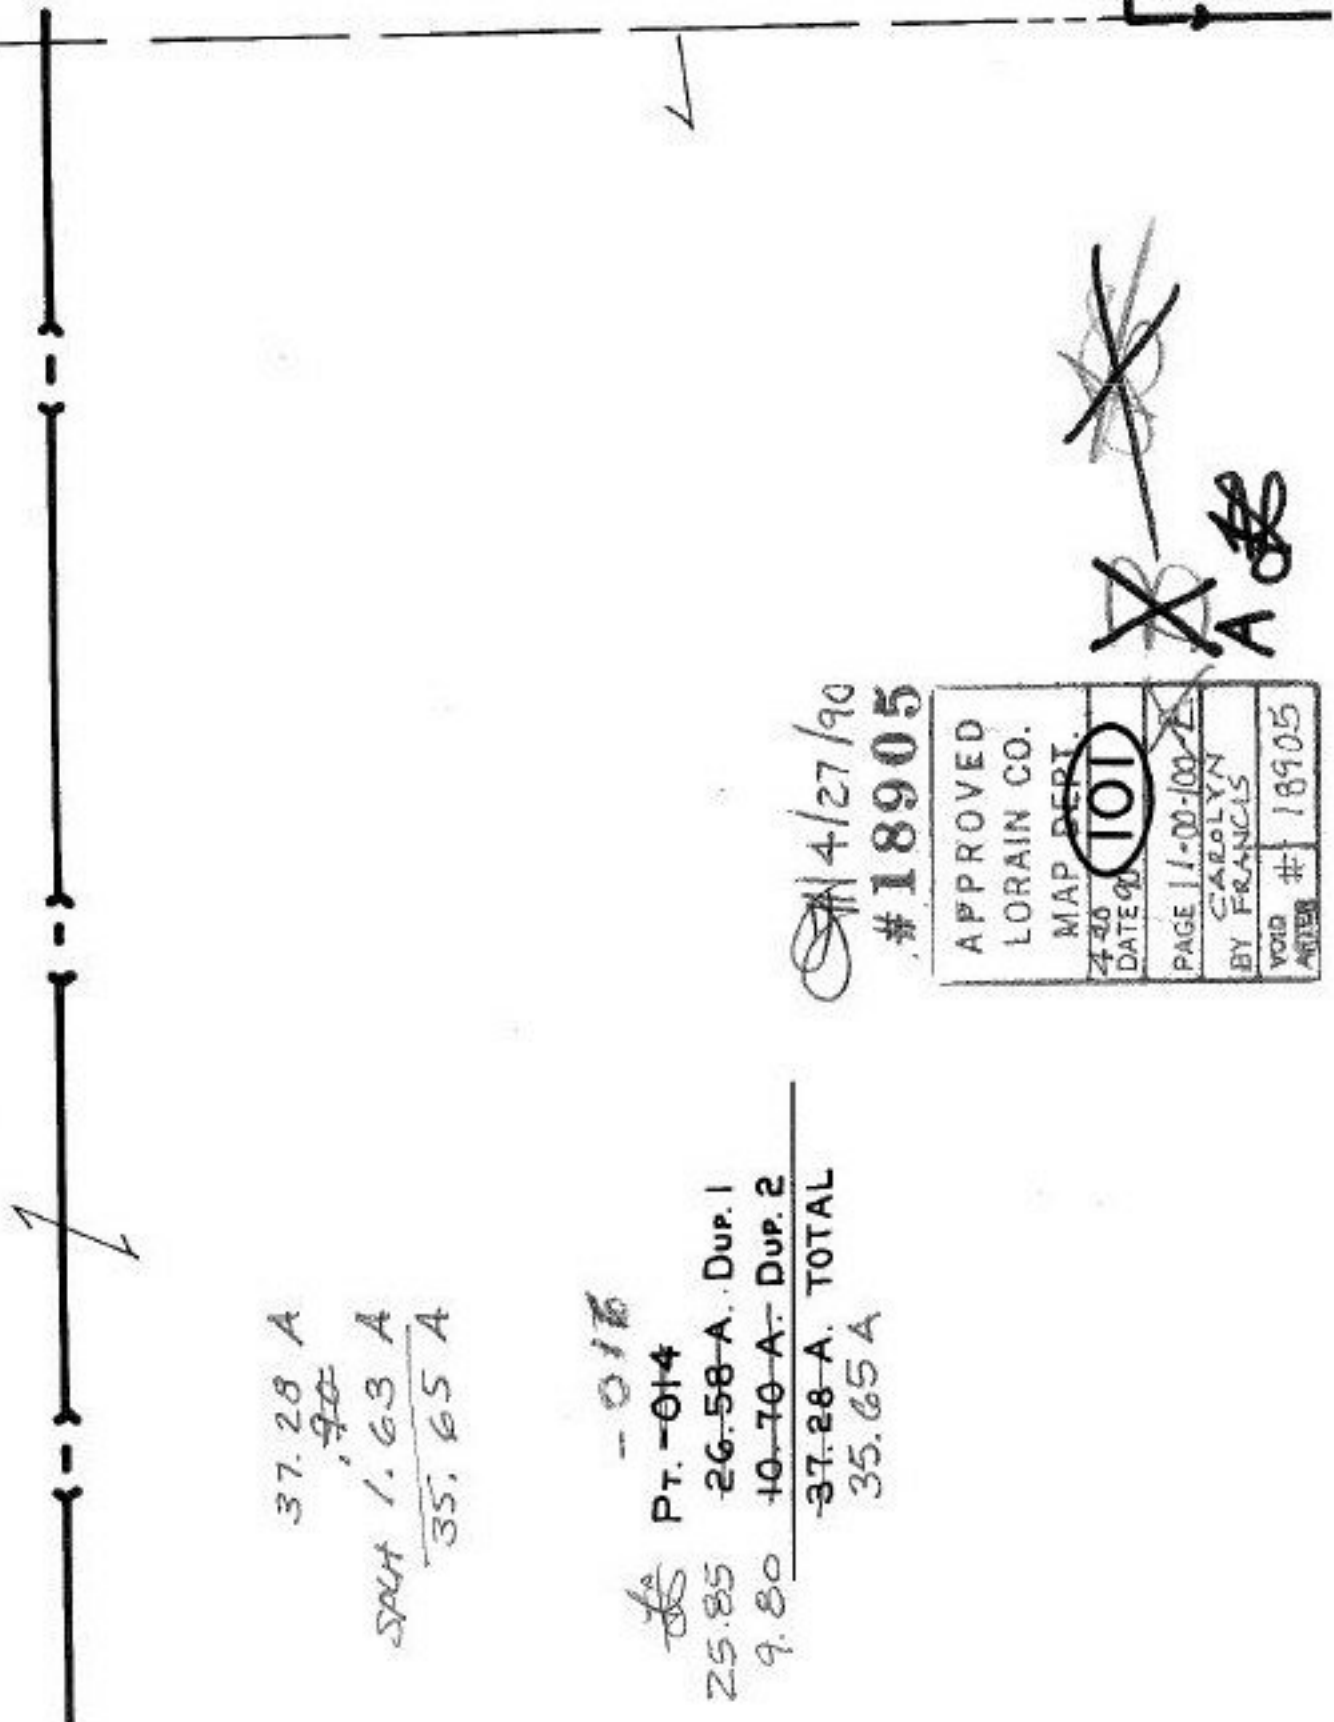

37.28 A
~~90~~
 SPAT 1.63 A
 35.65 A

-016
 P.T. -014
 25.85 26.58-A. Dup. 1
 9.80 10.70-A. Dup. 2
 37.28-A. TOTAL
 35.65 A

4/27/90
 #18905

APPROVED	
LORAIN CO.	
MAP DEPT.	
DATE 90	101
PAGE 11-00-100-1	
BY CAROLYN FRANCIS	
VOID AFTER #	18905

~~AS~~
 A ~~AS~~