

SE

280.00
25
233.96
513.96

75
25
150
130
280
515.14
513.96
1.18 DIFFER

365.14
130
235.14


130.00
233.96
363.96
150.00
513.96

233.96
130
363.96
515.14 - DEED
- 280.00 P.S. No. Front Added UP
235.14
- 233.96 Rec.
1.18 Different

ST 235.14
233.96

3143.34

D 3-A
PLACE OF BEGINNING
MUST BE CHANGE TO 513.96
DEED NO.

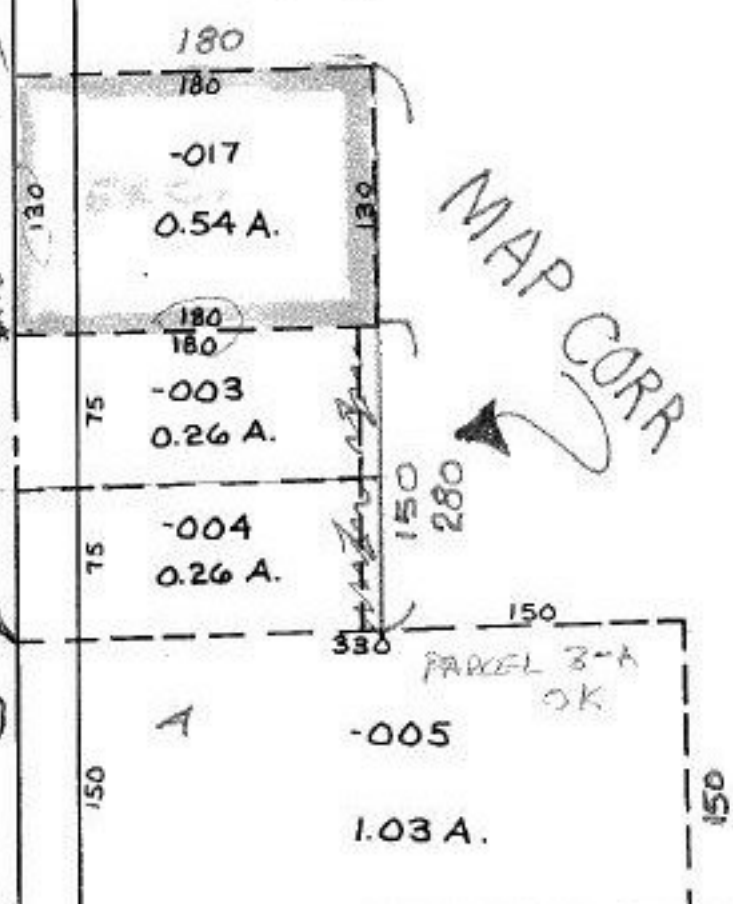

Deed Check
NO AC. CORR MADE

Deed Cover

16-00-003-101-002	19.20A
018	20.21A
16-00-004-000-001	6.41A
	45.82
16-00-003-000-017	0.54A
	46.36
16-00-003-000-017	
0.54 Ac. is the exceptio	

Problem with Dist. From
the place of begin.
RECORD - 513.96
DEED 515.14
2813.11

Other PARCEL (-002, 1/2001
Need exceptions, or Added
To Deed. To be Transferred.

9125190
18905
18905

APPROVED
LORAIN CO.
MAP DEPT.
DATE 5-22-90
PAGE 16-00-003A
BY CAROLYN
FRANCIS
VOID AFTER # 18905A

-012