

SEE 4-00-023-F


DISTANCE PER SURVEY
BY KS A.S.S.O.C.

RIEGELSBERGER

RD.

RD.

RD.

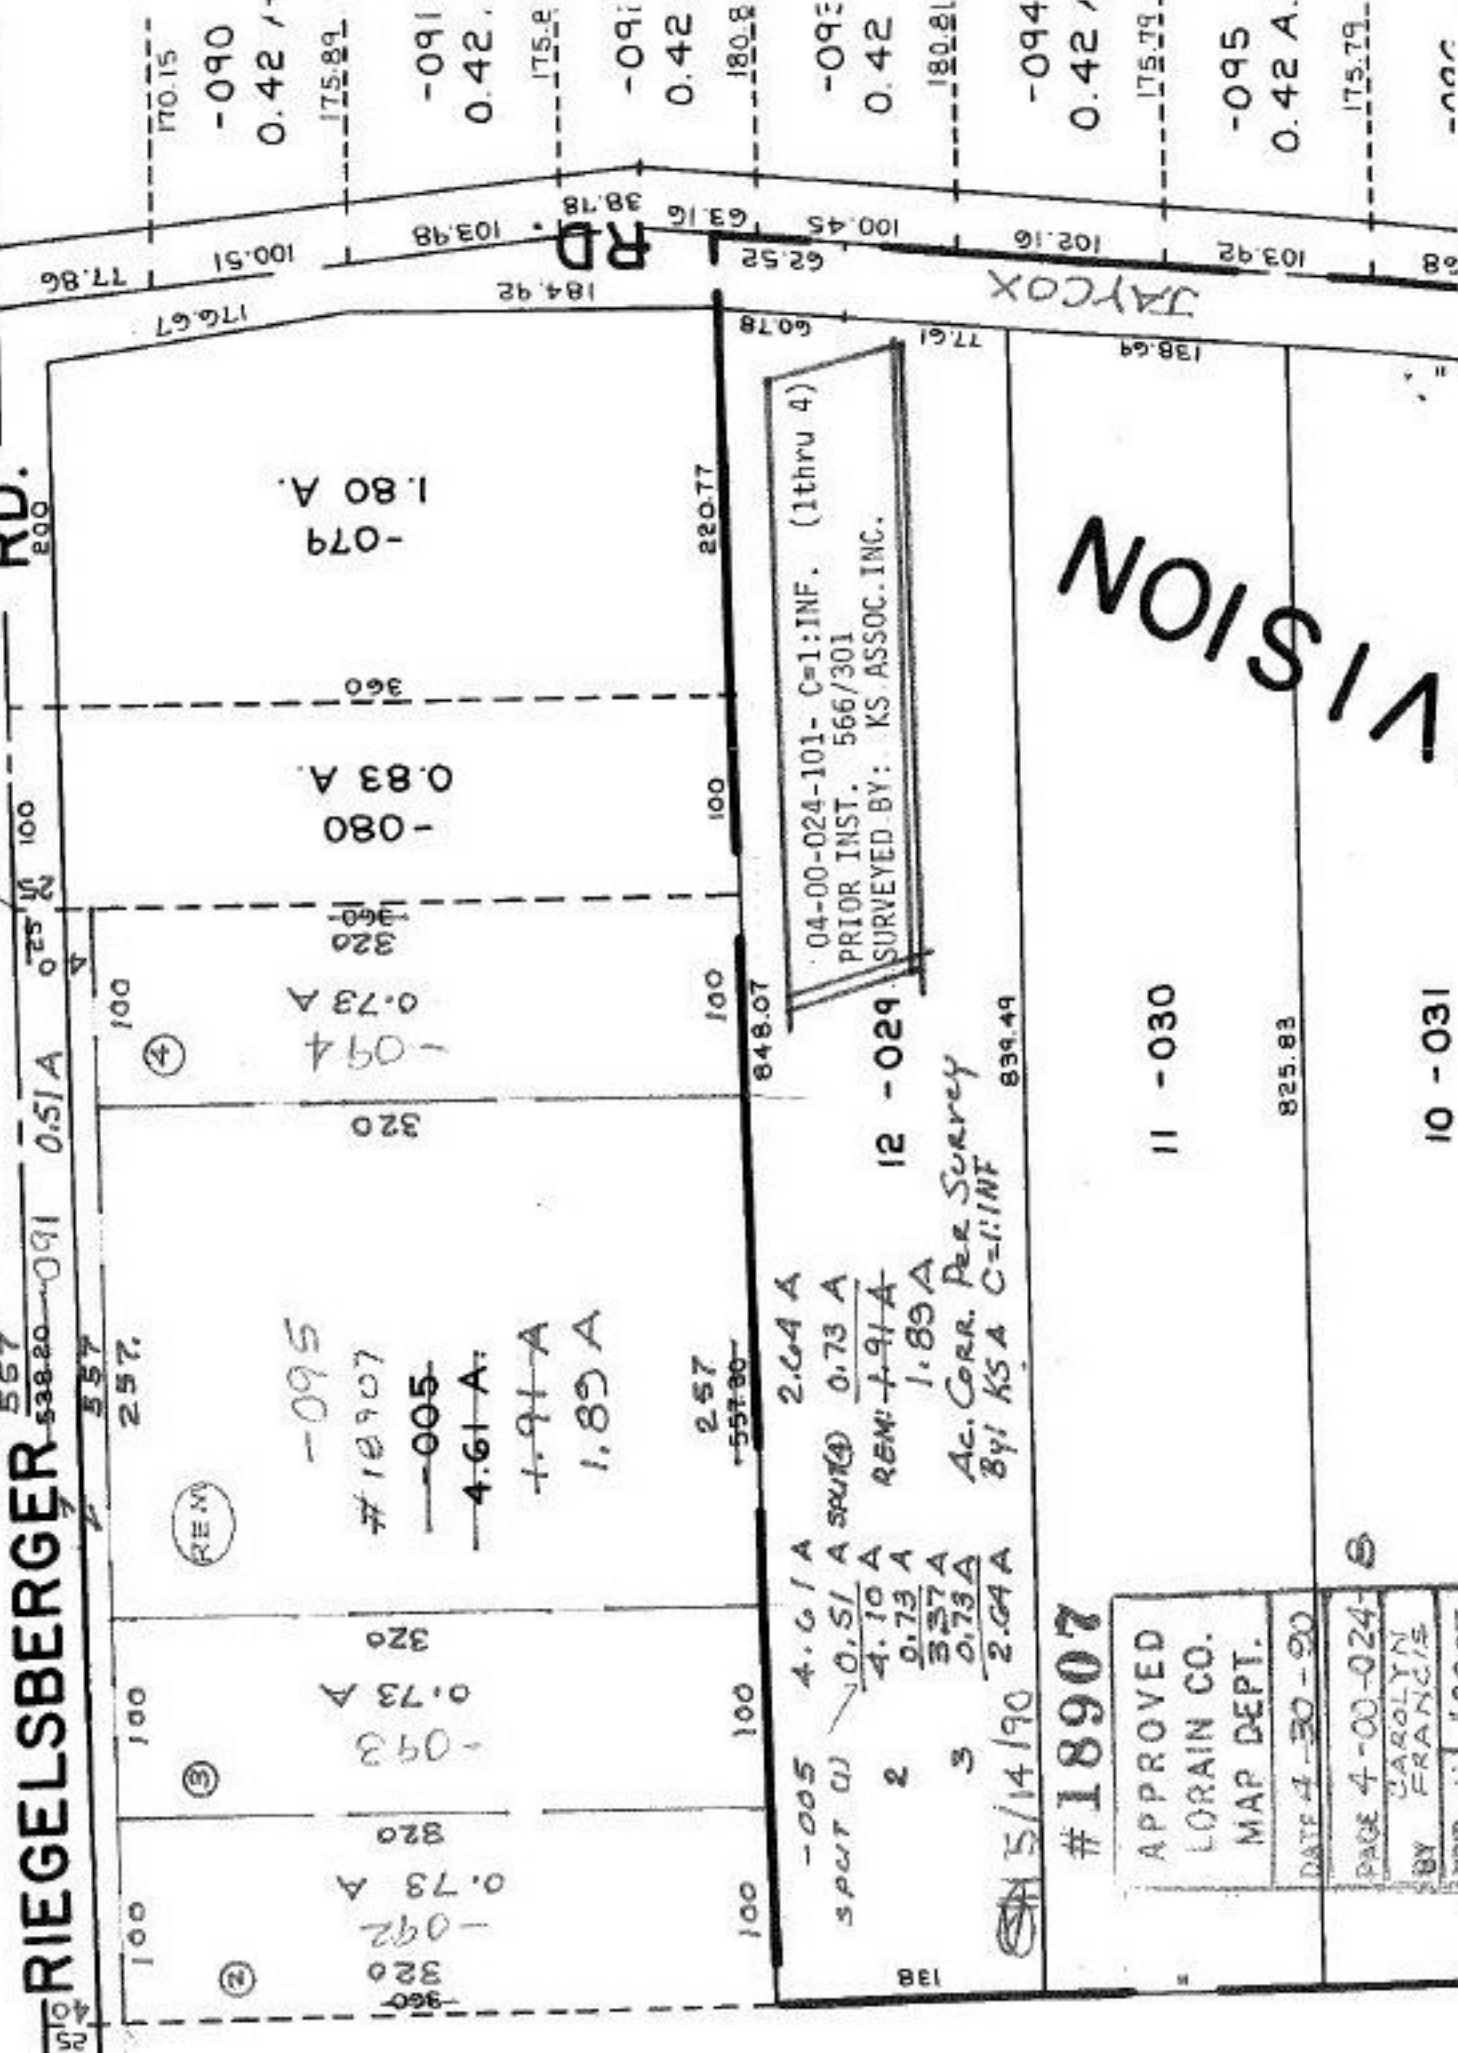

VISION

#18907

APPROVED
LORAIN CO.
MAP DEPT.

DATE 4-30-90

PAGE 4-00-024-5

BY CAROLYN
FRANCIS

14018 #18907