

SEE 10-00-022-D

SEE

#18920

APPROVED
LORAIN CO.
MAP DEPT.
DATE 5-11-90
PAGE 10-F
BY CAROLYN FRANCIS
VOID AFTER # 18925

10-00-023-101

9/25/90 -022
#18925

APPROVED
LORAIN CO.
MAP DEPT.
DATE 5-11-90
PAGE 10-F
BY CAROLYN FRANCIS
VOID AFTER # 18925

10-00-023-101-
DORIS UNCT 1957/27E -005

74.25A

104.63
-16.63
88.00

-002
15.00A.

18720 -042
PT. -040
PT. -027
PT. 89-13A
78.06A
74.06 Ac

1571

2708.26

-022

17.17A.

101

2704.55

-029

15.03 A.

2705.68

APPROVED
LORAIN CO.
MAP DEPT.
DATE 5-11-90
PAGE 10-F
BY CAROLYN FRANCIS
VOID AFTER # 18925

-017
37.71A.

2702.90

294.93
-041
4.00 Ac
591

591

-026
8.00A.

591


2706.88

2-028 2.14A. 2
622 622

10-00-023-101-
PRIOR INST. 1252/375
SURVEYED BY: KS ASSOC.
C=1:250000.

SECS. - S 1/2 12, S.W. 1/2 18, 19, 22, 8

MON. BUCK
AT 31.92' E. OF
4L 501

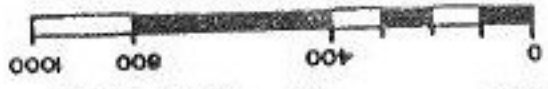

E TWP.

LATASBURG

W ELYRIA