


MORGAN ST. MAIN ST. 66'

C. 73-2 #1457

See Misc. Vol. 4 Pg 438 for Street Width.

573.27 SOUTH PROFESSOR ST. 90°

V5/0 100 LINKS

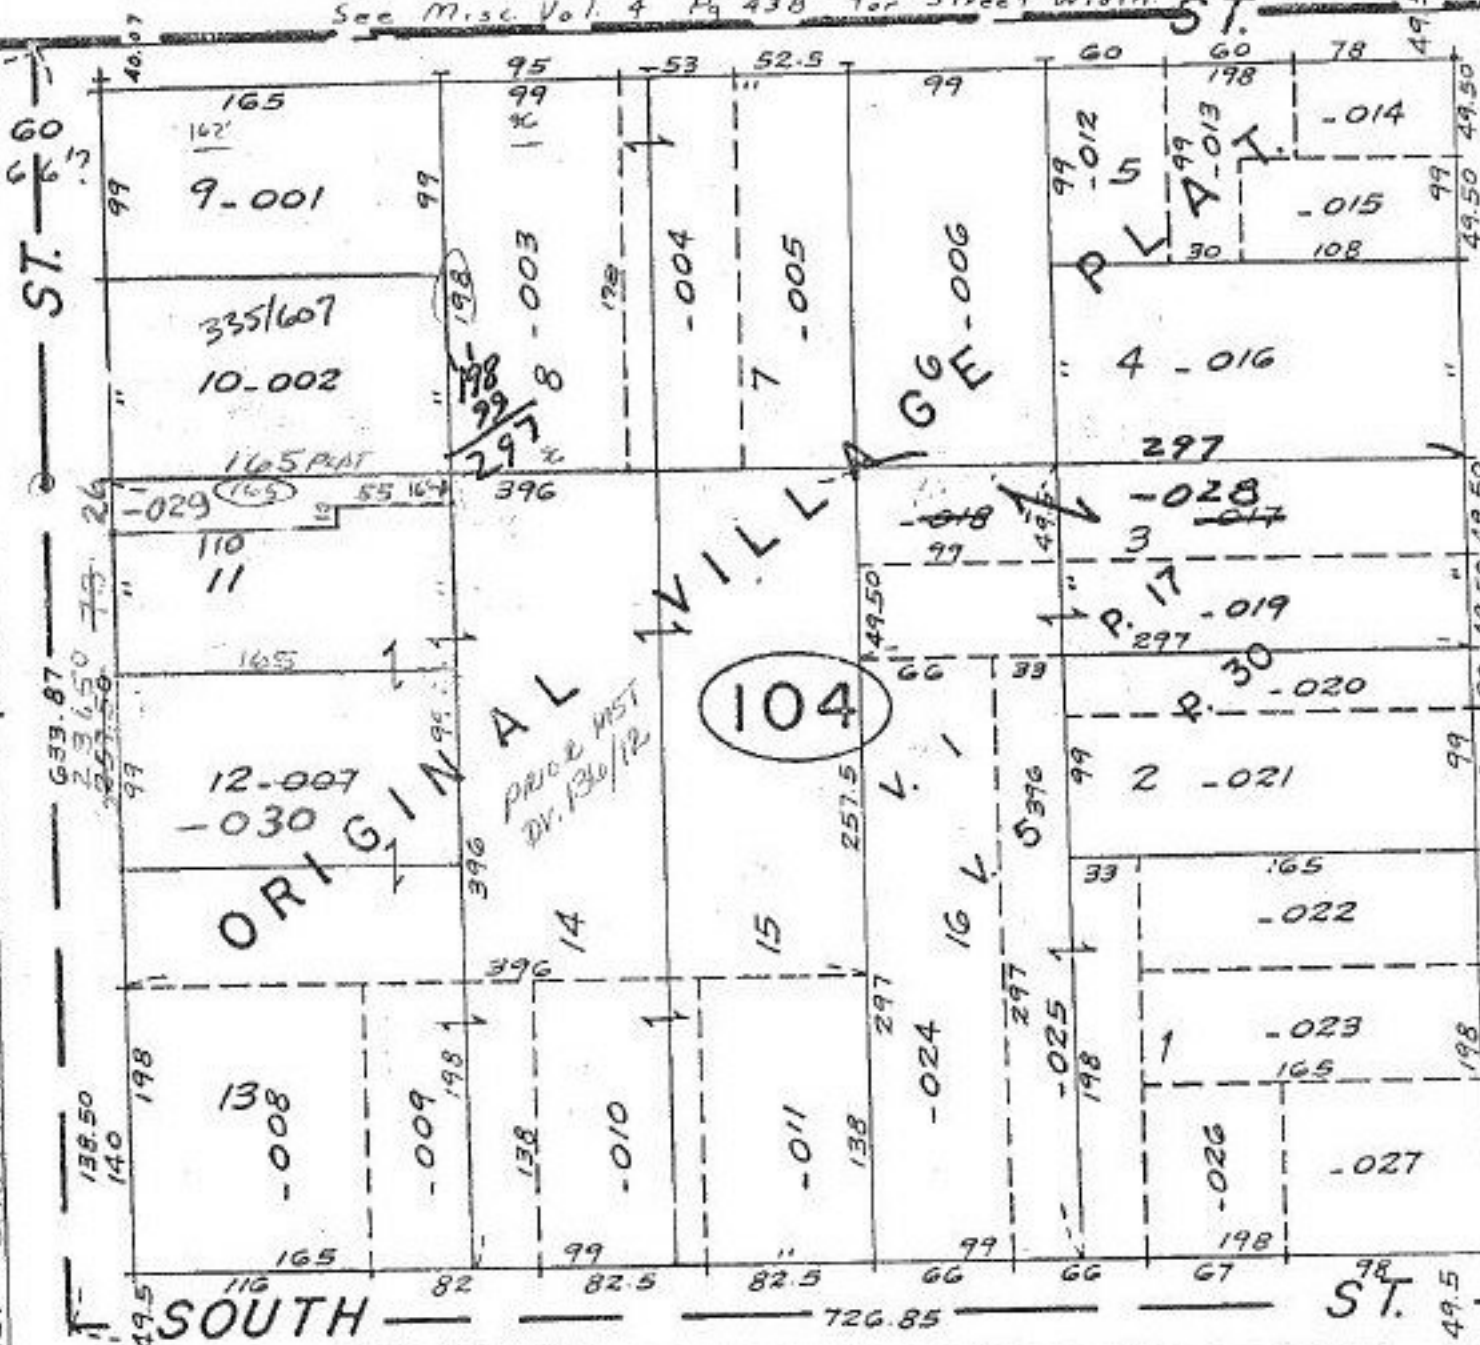

#14579

#14579

APPROVED
LORAIN CO.
MAP DEPT.
DATE 3-11-82
PAGE 9-00-095B
BY *J. Ballant*
VOID AFTER #14579

105

9/14/90 #18932

APPROVED
LORAIN CO.
MAP DEPT.
DATE 5-2-90
PAGE 9-00-095-B
BY CAROLYN FRANCIS
VOID AFTER # R 18932

#14579

500

09-00-095-104- PRIOR INST. DV. 136/12⁹³ C=1:INF.
SURVEYED BY CHARLES P. WARYU REG. SURVEYOR

316