


SEE 18-C

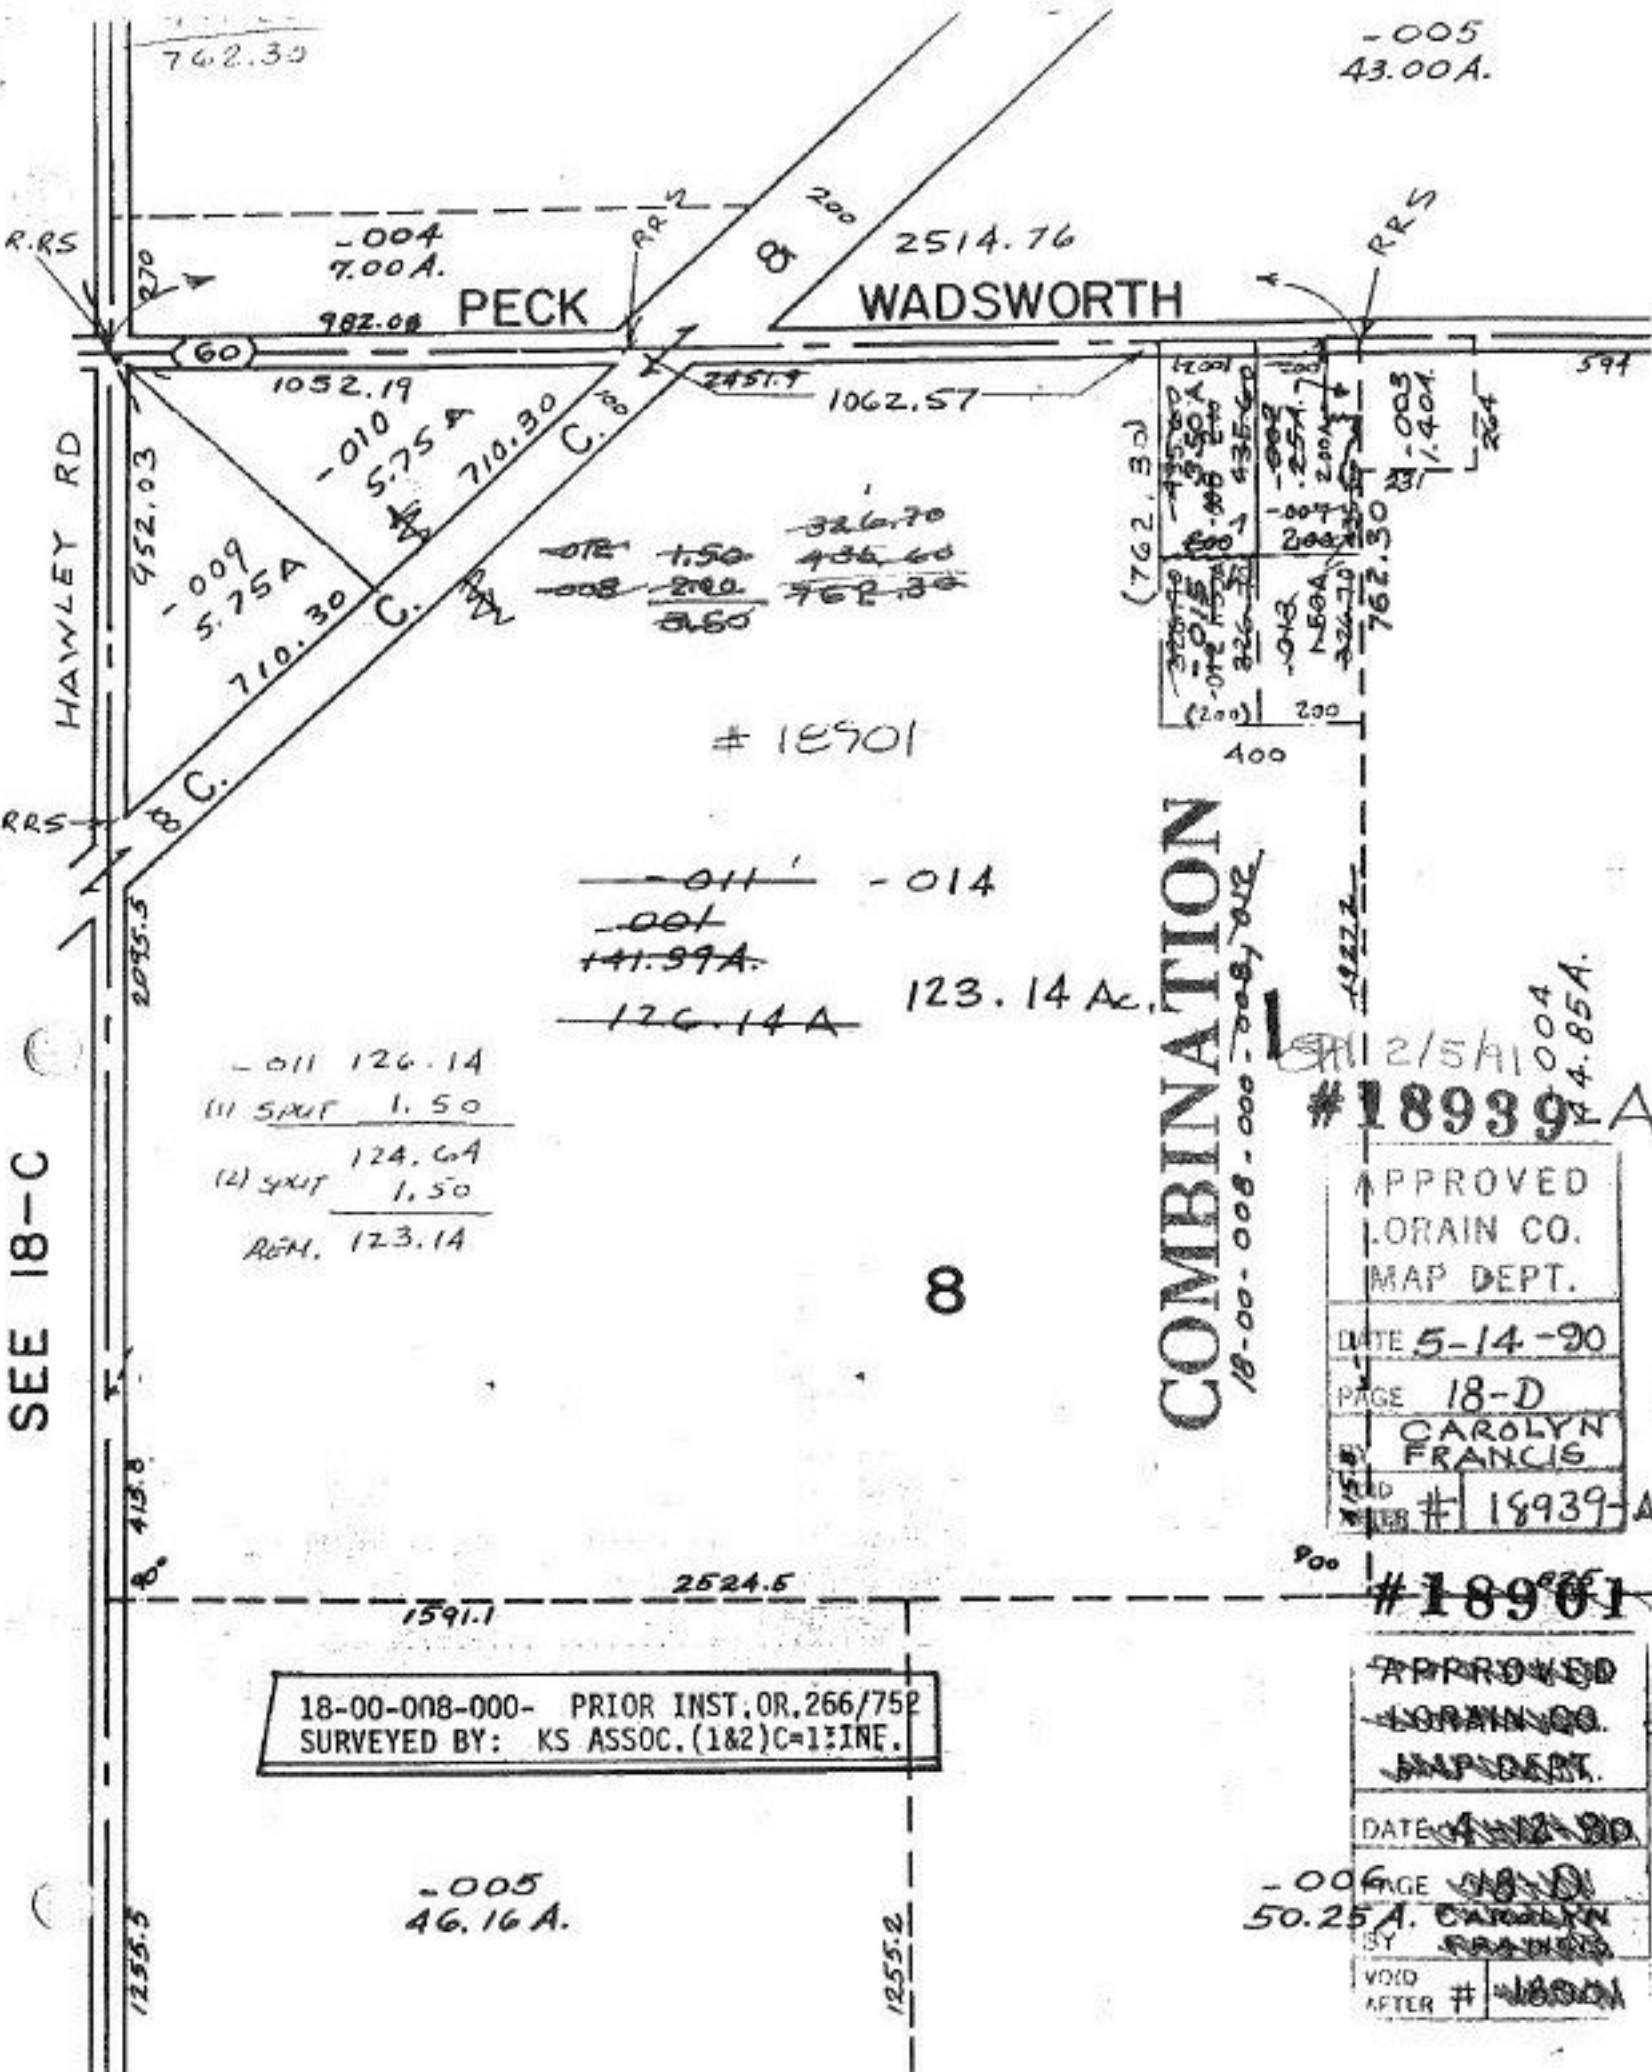

-005
43.00A.

-004
7.00A.

WADSWORTH

PECK

-010
5.75A

-009
5.75A

~~012 1.50~~ ~~326.70~~
~~008 2.00~~ ~~435.60~~
~~0.50~~ ~~762.30~~

18901

~~-011~~ -014

~~-001~~
~~+41.99A~~

~~-126.14A~~ 123.14 Ac.

-011 126.14
~~(1) 5X12 1.50~~

124.64
~~(2) 5X12 1.50~~

REM. 123.14

COMBINATION

18-00-008-000-008-012

18939 A

APPROVED
ORAIN CO.
MAP DEPT.

DATE 5-14-90

PAGE 18-D

CAROLYN FRANCIS

18939-A

18901

APPROVED
ORAIN CO.
MAP DEPT.

DATE 5-14-90

-006
50.25A. CAROLYN FRANCIS

VOID AFTER # 18901

-005
46.16A.

1255.2

1255.5

1591.1

2524.5

900

413.8

2095.5

952.03

970

762.30

1052.19

710.30

2451.7

1062.57

200

2514.76

594

400

1922.2

1.40A

762.30

200

200

(762.30)

1200

1200

