

1529.88

1877.04

400.6  
90°11'

89°43'

372

835.07

INCL PARCEL NO. 1

07-00-028-101-001  
002  
089 PART

PARCEL NO. 4

07-00-032-000-009  
PART OF 07-00-032-000-008

XXXXXXXXXX

07-00-033-000-001  
002  
003  
004  
005  
028

07-00-034-000-004  
005

07-00-039-000-019

07-00-040-900-907

07-90-032-000-013

PARCEL NO. 2

PART OF 07-00-028-101-089

PARCEL NO. 3

I THINK

07-00-029-000-010  
011

-001  
138.40

3494.98  
3496.40

40

-003  
75.02 A.

-004  
38.00 A.

2487.23

-007  
29.00 A.

4538

206.50  
210


5066.7

1447.27

3470.28

1203.50

835.07

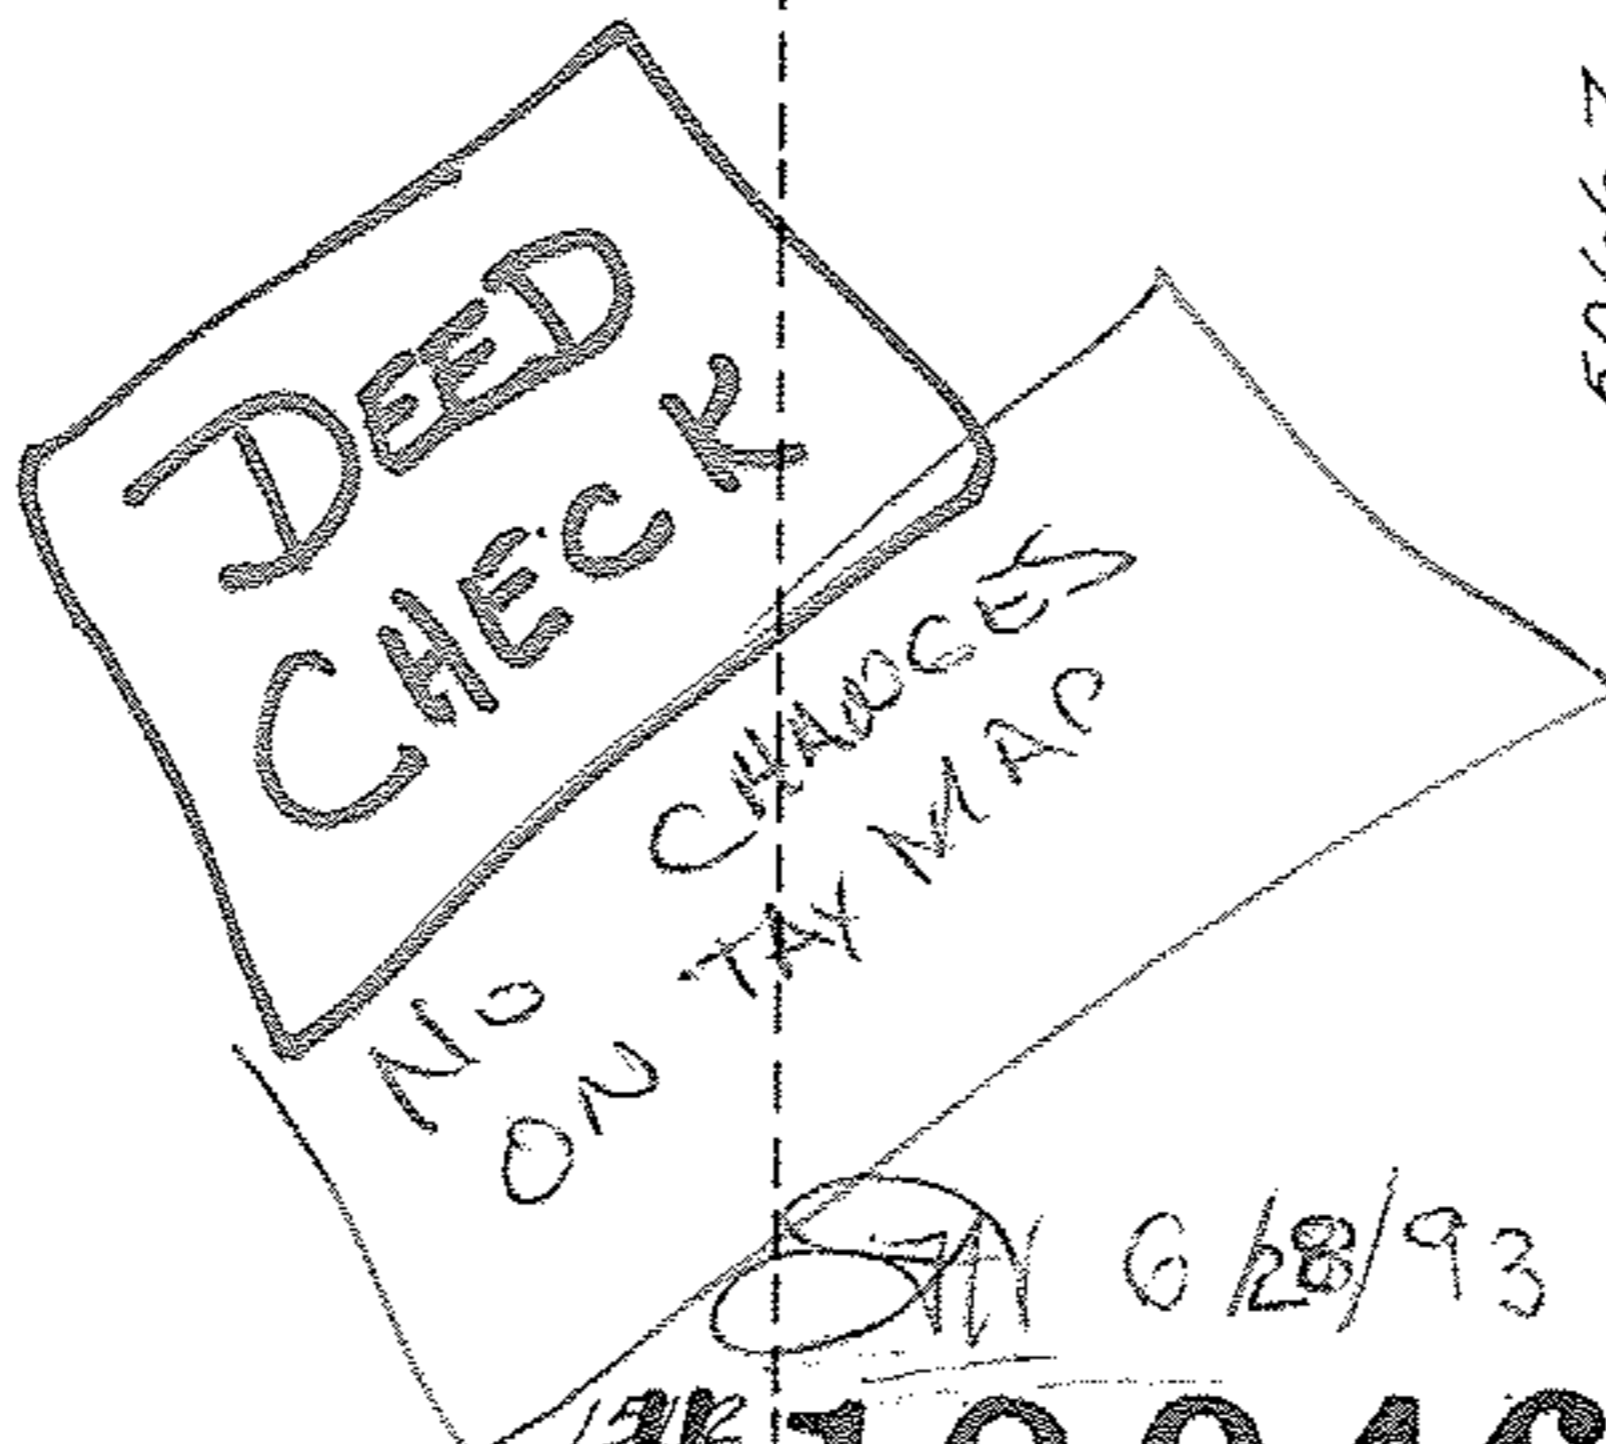

6/28/93

#18946A

|            |                    |
|------------|--------------------|
| APPROVED   |                    |
| LORAIN CO. |                    |
| MAP DEPT.  |                    |
| DATE       | 6-25-93            |
| PAGE       | 7-A                |
| BY         | <i>[Signature]</i> |
| VOID AFTER | 18946A             |

724.77  
720.72

-002  
17.12 A.

1034.22  
1038.67

1033.17

1650.62

317.02

215.45

605.14  
-005  
3.00 A.

215.50

-006  
11.30 A.

2472 2495

to &