


Prior Deed Not Surveyed
1303/843

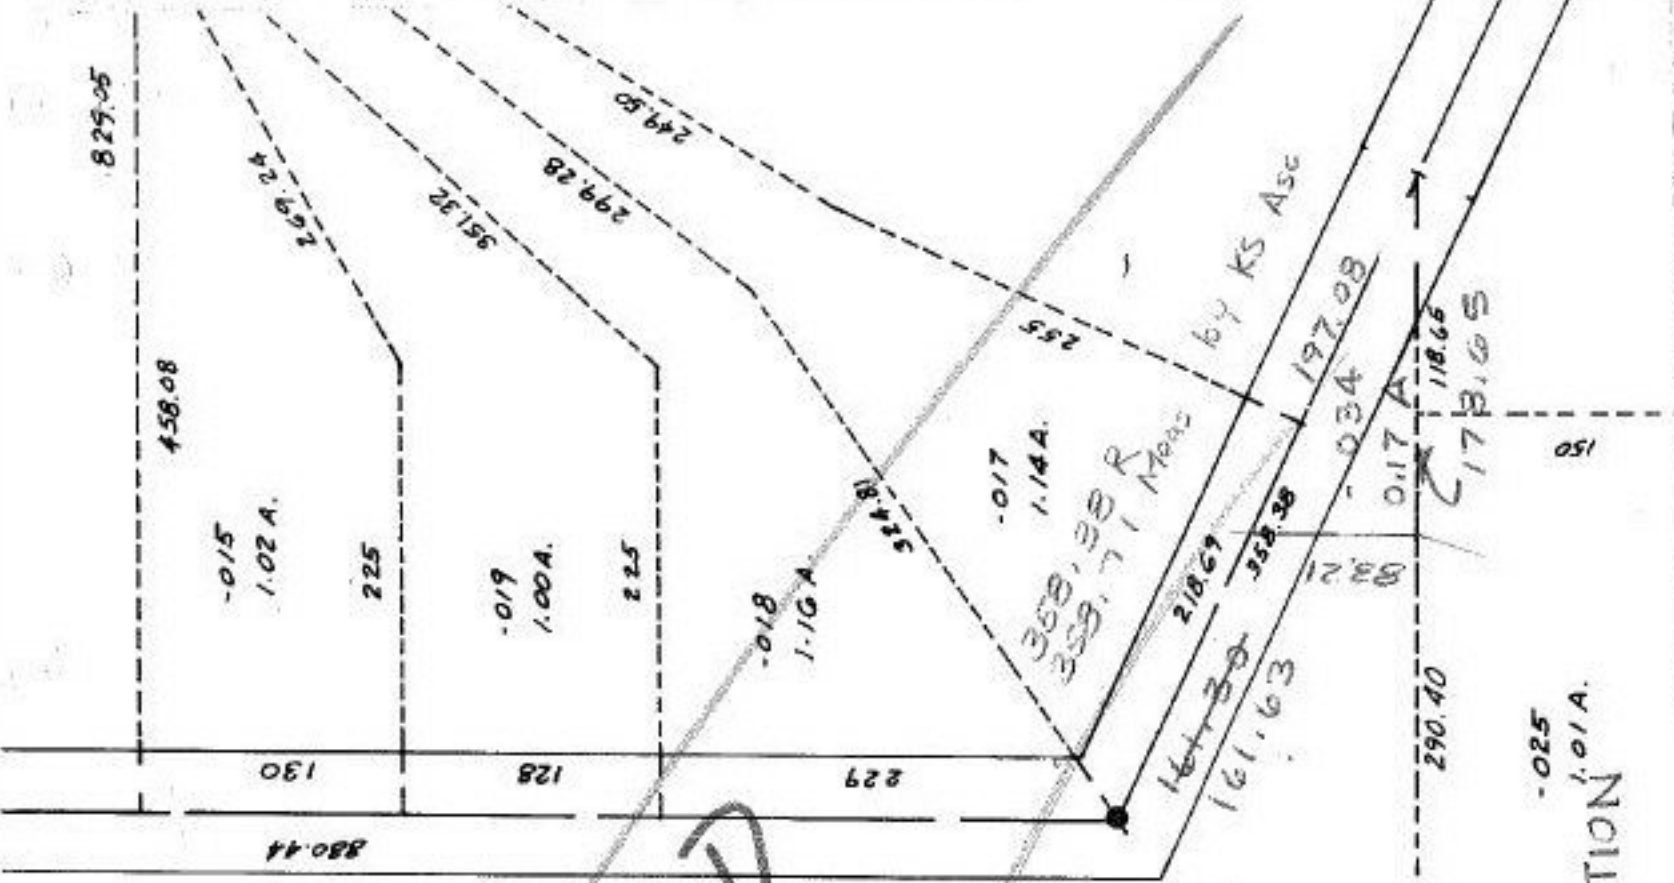

~~Pl. 001~~
Pl. 42.33A

Pl. -035
Pl. 42.16 Ac.

VOID

APPROVED
LORAIN CO.
MAP DEPT.
DATE 6-15-90
PAGE 12-00-054 B
BY CAROLYN FRANGIS
VOID AFTER # 18960

12-00-054-000-
PRIOR INST # 1422/101
SURVEYED BY: KS. ASSOC.
C-1: 52, 631

WARRANTY
DEED
1303/843

1422/101 Mortgage
DEED

← 2088.90
← 2072.57

42.33A
<u>0.17 A</u>
42.16 A
358.71
358.38
<u>0.37</u>
0.03
358.71
197.08
<u>161.63</u>

VOID 9-14-90
Pl. -026
Pl. 11.44 A. NEW DESCRIPTION 1.01 A.