



SEE 13-A

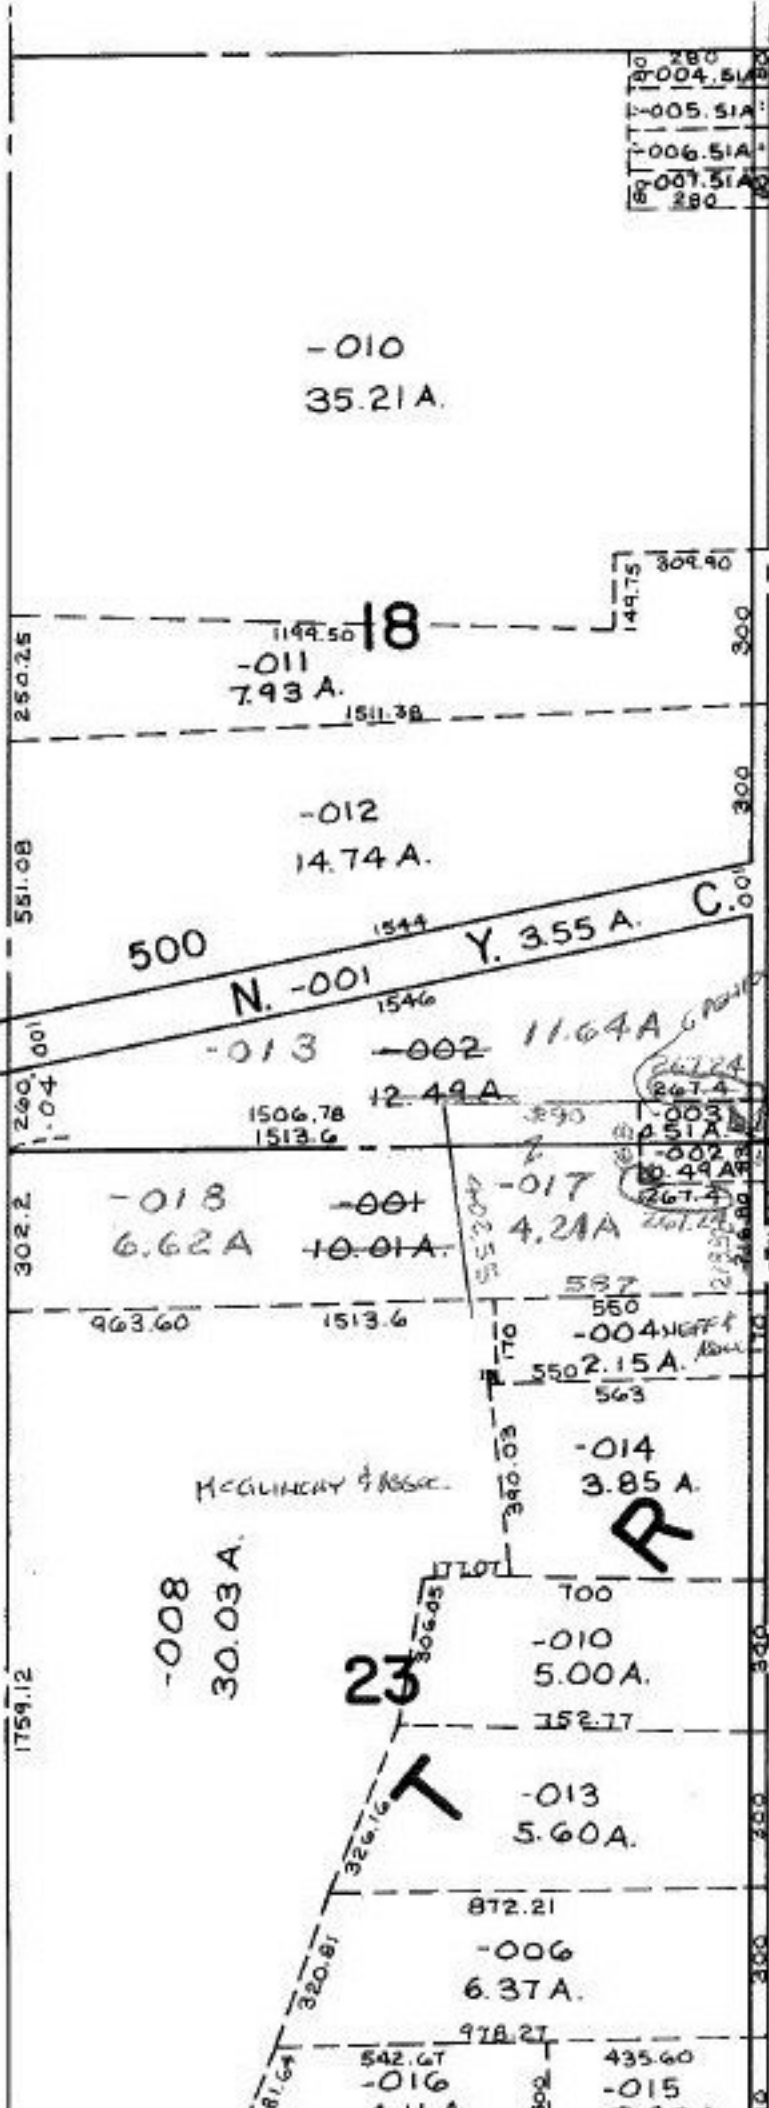

280
004.51A
005.51A
006.51A
007.51A
280

13-11-018-000- PRIOR INST. 998/989  
 13-11-023-000-SURVEYED BY JOHN POZYWAK  
 Reg. Surv.  
 C=1:500,000.

SEE 13-11-017  
 T

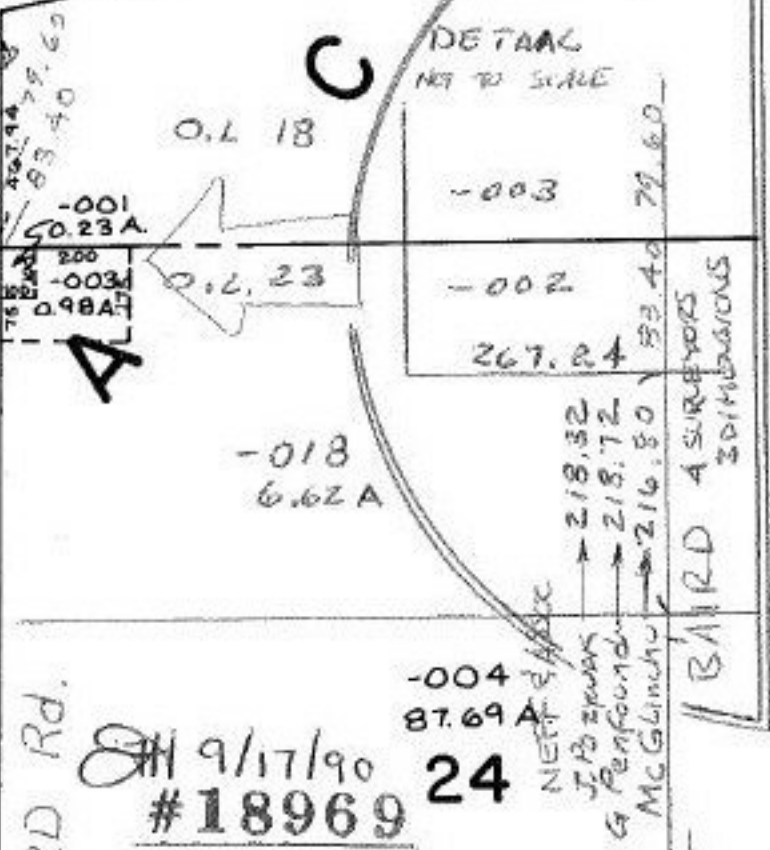

BAIRD Rd.

9/17/90  
 #18969

APPROVED  
 LORAIN CO.  
 MAP DEPT.

DATE 6-12-90

PAGE 13-B

BY CAROLYN FRANCIS

VOID AFTER #18969

BAIRD 4 SURVEYORS  
 301 HIGHLANDS  
 218.32  
 218.72  
 216.80  
 McGLINCHY