

LATTASBURG-ELYR.A

40.00A.

464.52
253.00
256.52


482.75
202.05
280.70

-012 11.49 A
5.02 A
6.47 A

-001
50.00 A.

-002
50.00 A.

95

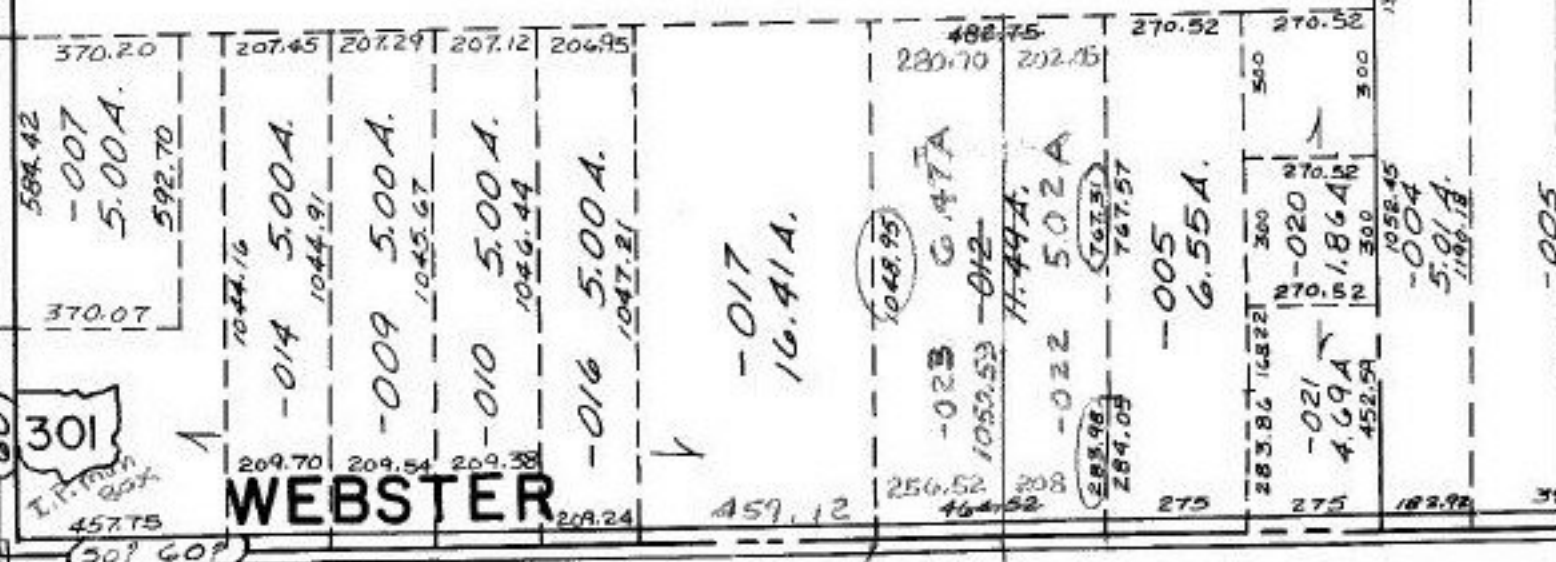

WEBSTER

1754.73
2011.25

SEE 19-C

LAGRA

SCALE 1" = 4'

#18987

66, 67, 74, 75, 86, 87, 94, 95

1/30/91

15-00-095-000- PRIOR INST. 1311/591 C=1:INF.
SURVEYED BY: DOUG MOSLEY REG. SURVEYOR

APPROVED
LORAIN CO.
MAP DEPT.

DATE 6-14-90

PAGE 159

CAROLYN
BY FRANCIS

VOID
AFTER # 18987