


18871

100.60 65 STREET DEDICATION PLAT (900) 947.43 -001 3.96 A. PAF 1430

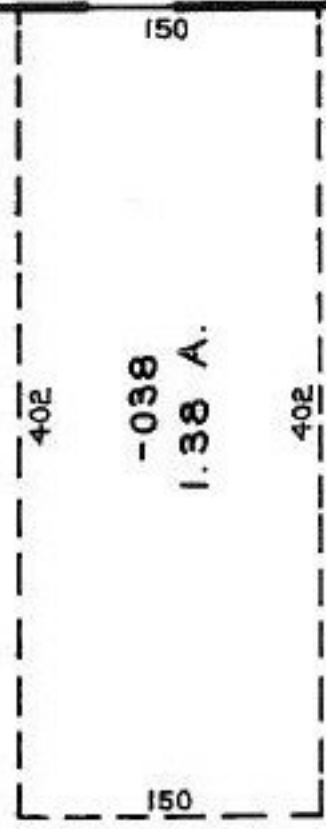

~~039~~ → -039
~~51.14 A.~~ → 51.40 A.

TAX MAP ALREADY FIXED
ERRISE SPUE NO

SIN 1/14/90
#18988-A

APPROVED LORAIN CO. MAP DEPT.	
DATE	4/13/90
PAGE	3-00-005-A
BY	T.M. Goin
VOID AFTER	18988-A

208.04

-005
1.68