
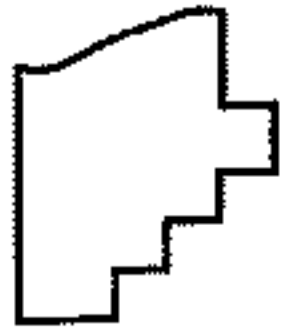


PARENT PARCEL: 04-00-022-102-046
 CHILD PARCEL: 04-00-022-102-155, -156
 STARTING POINT: INTERSECTION OF C/L OF MIDDLETON DR. AND C/L OF JAYCOX RD.

19-00765

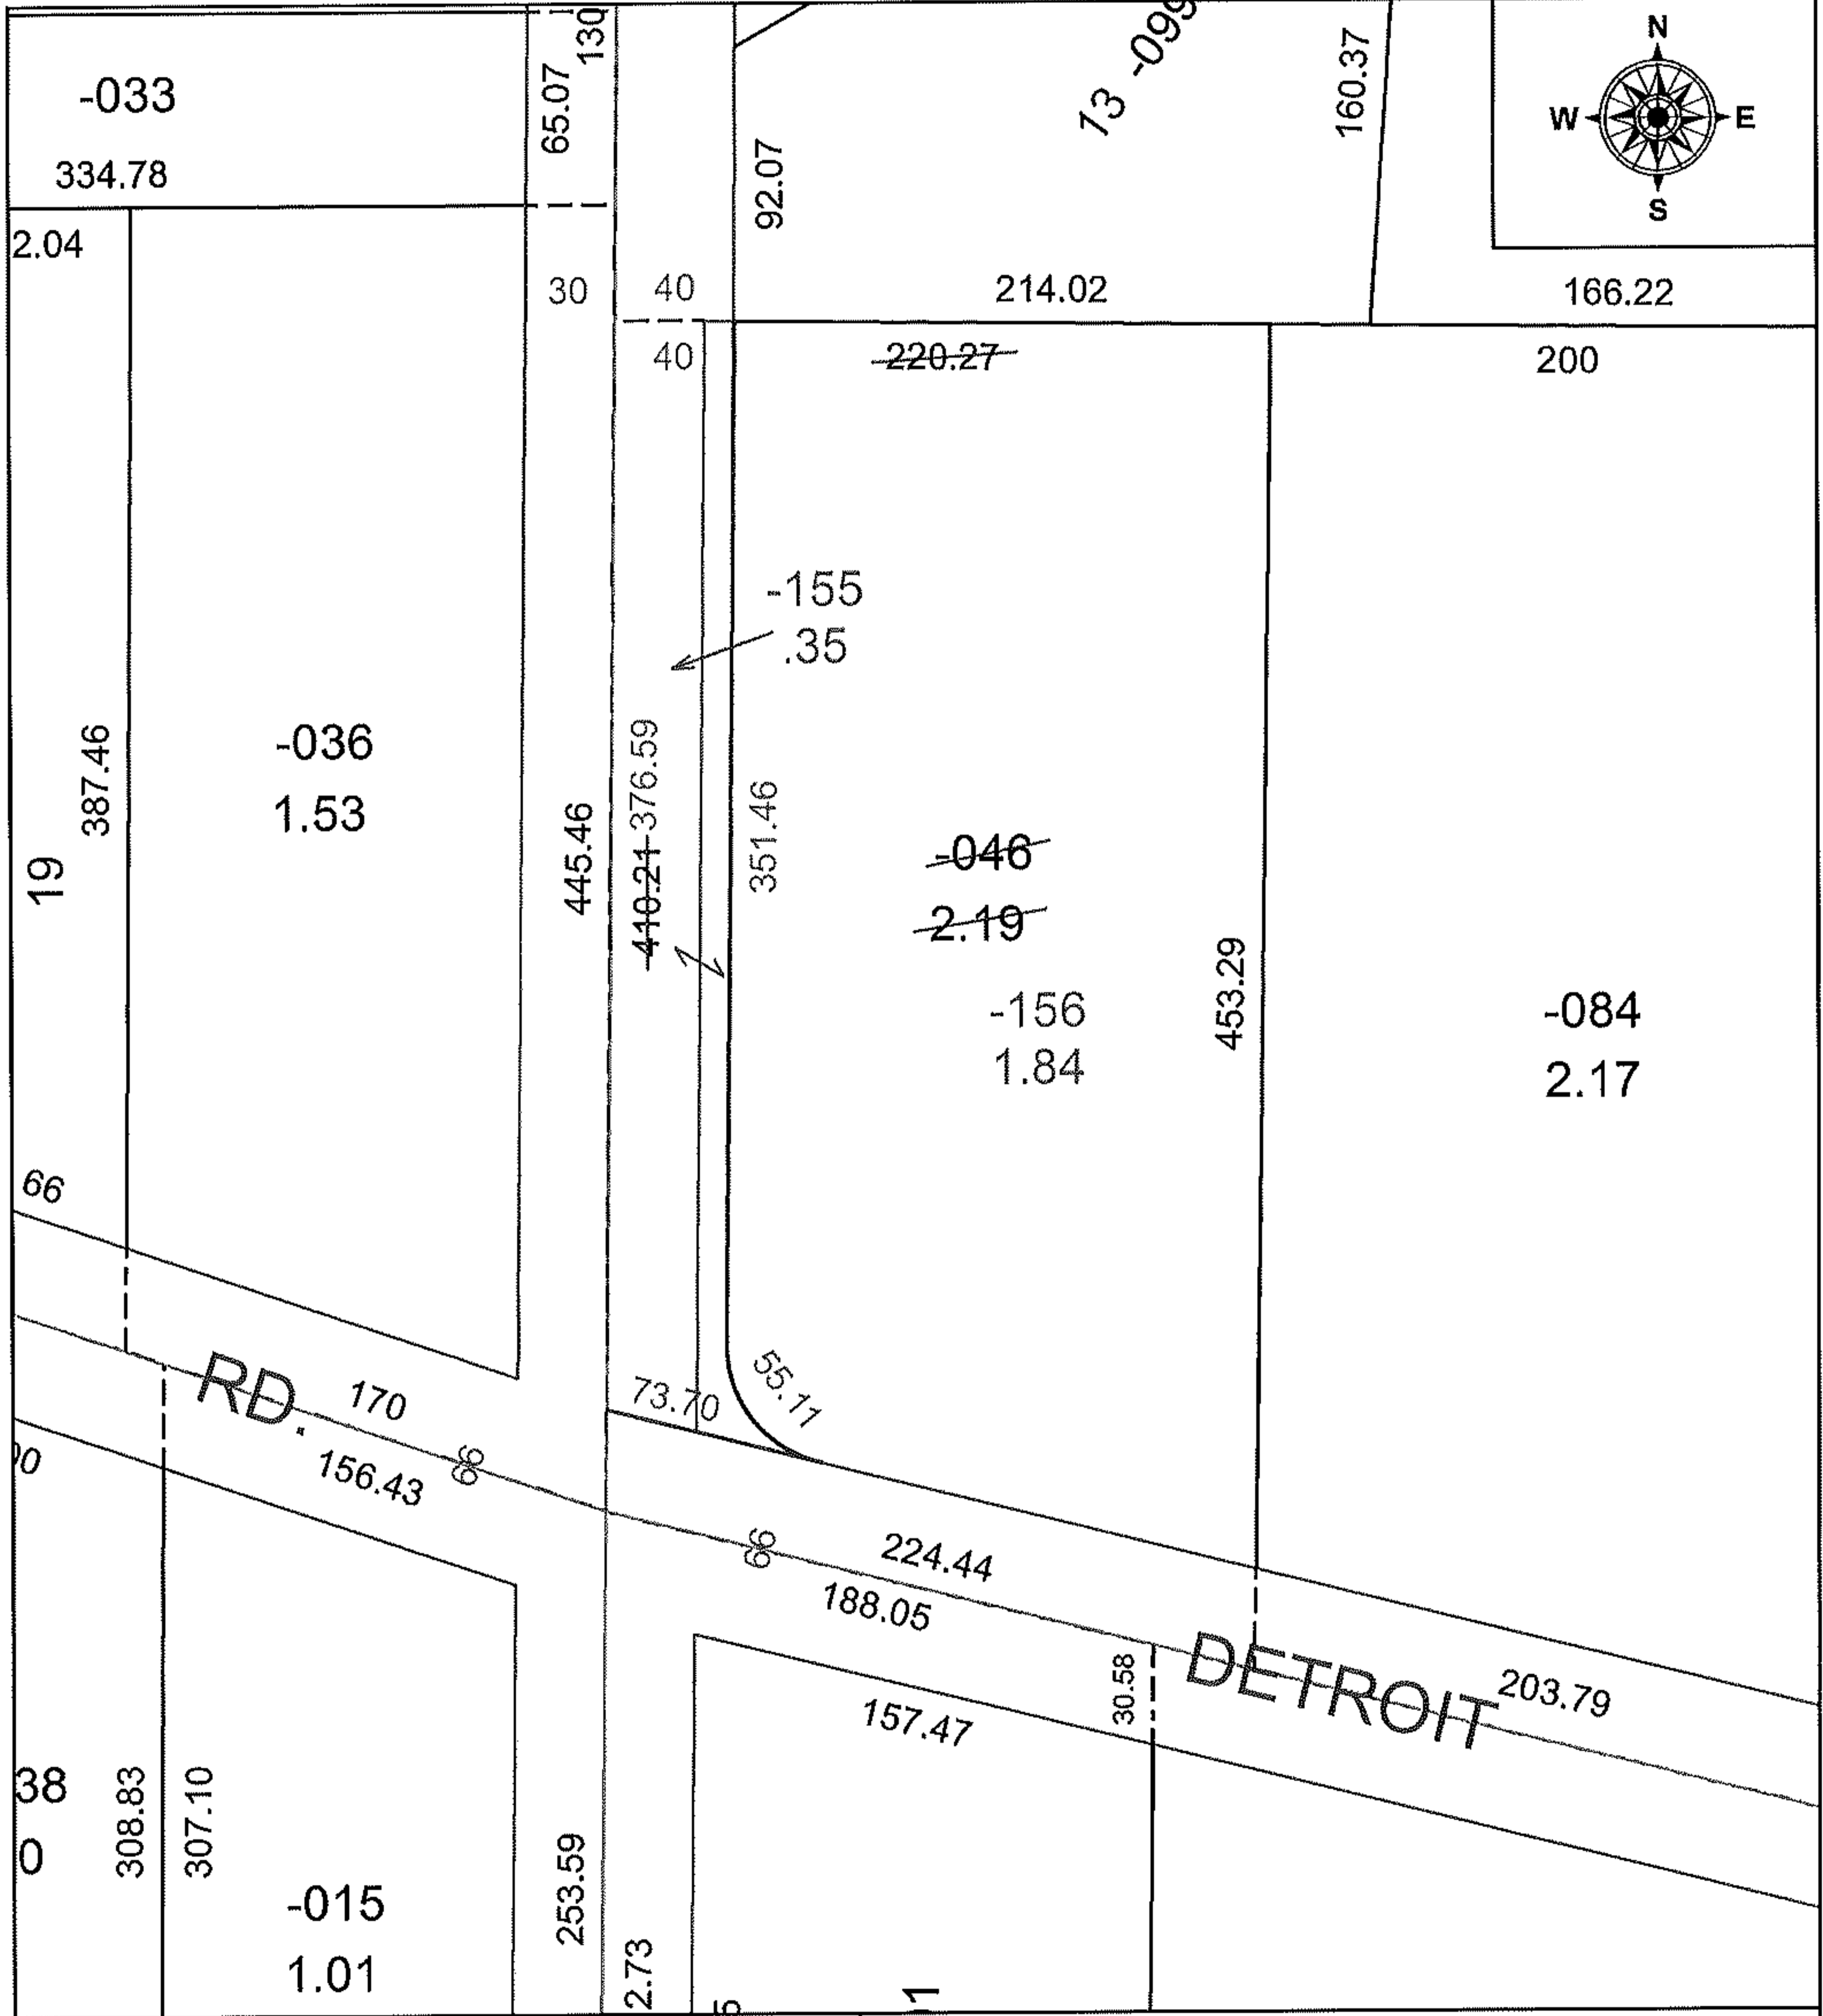

SPLITS/DEEDS PROCESSED
 LORAIN COUNTY TAX MAP DEPARTMENT
 226 MIDDLE AVE. ELYRIA, OH

SURVEYED BY: MICHAEL P. SPELLACY
 CLOSURE: 1:57,589
 MAP PAGE(S): 4-00-022
 APPROVED BY: RRM DATE: 11-4-19
 SCALE: 1" = 75' PRIOR INSTRUMENT: 20170654230