


EXHIBIT-A-1

PLAT ON

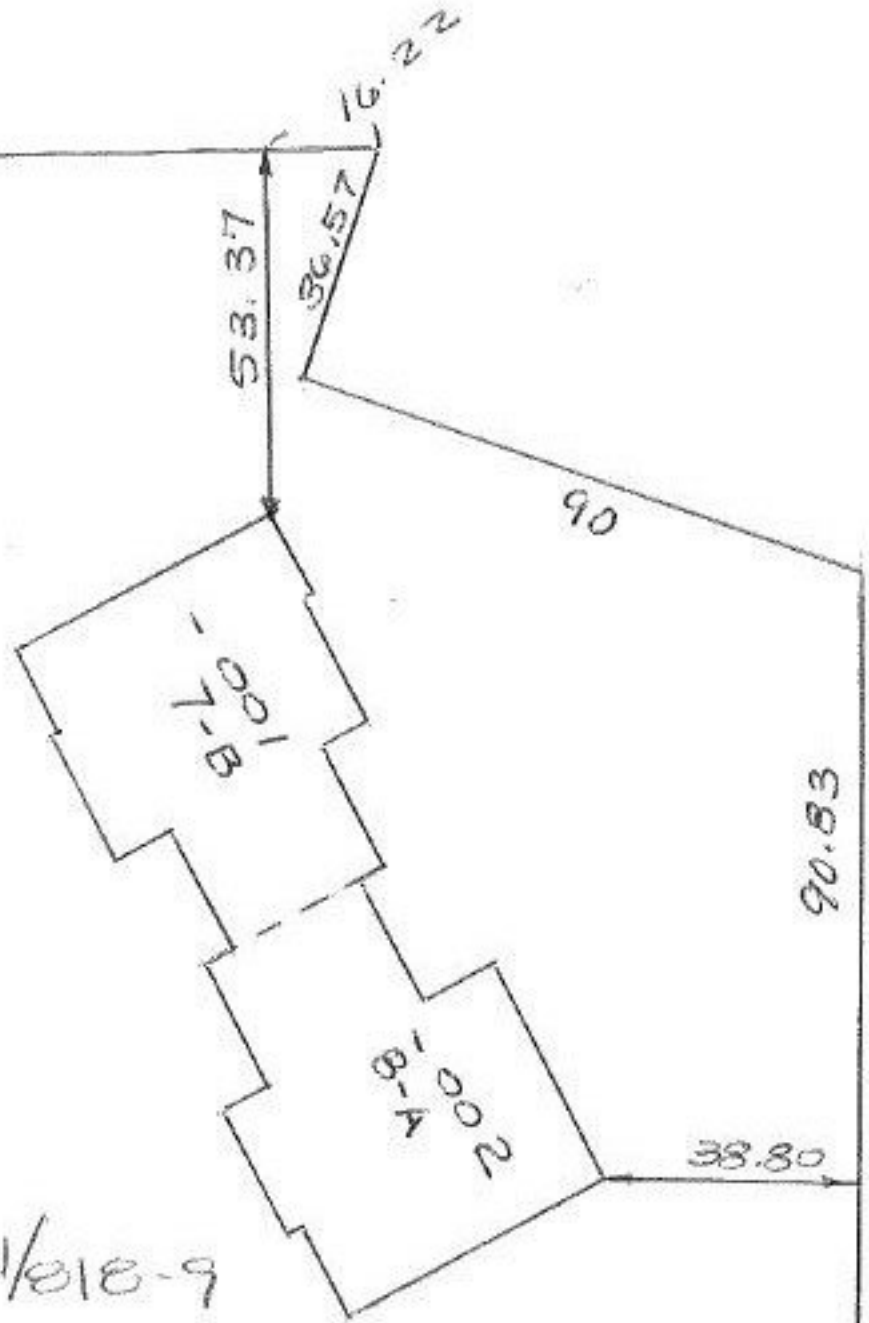

SEE OR 301/818-9

CORRECT FOR UNIT 7E8

BUR-OAKS CONDO PHASE III
VOL. 45 Pgs. 48-54

#19004A

APPROVED
LORAIN CO.
MAP DEPT.
DATE 8-10-90
PAGE 6-34-A
BY CAROLYN FRANCIS
VOID AFTER #19004A

PLAT CONDO CORR.
BOENS RD.