


**3
OAKS
DOMINIUM
5 PGS. 48-54**

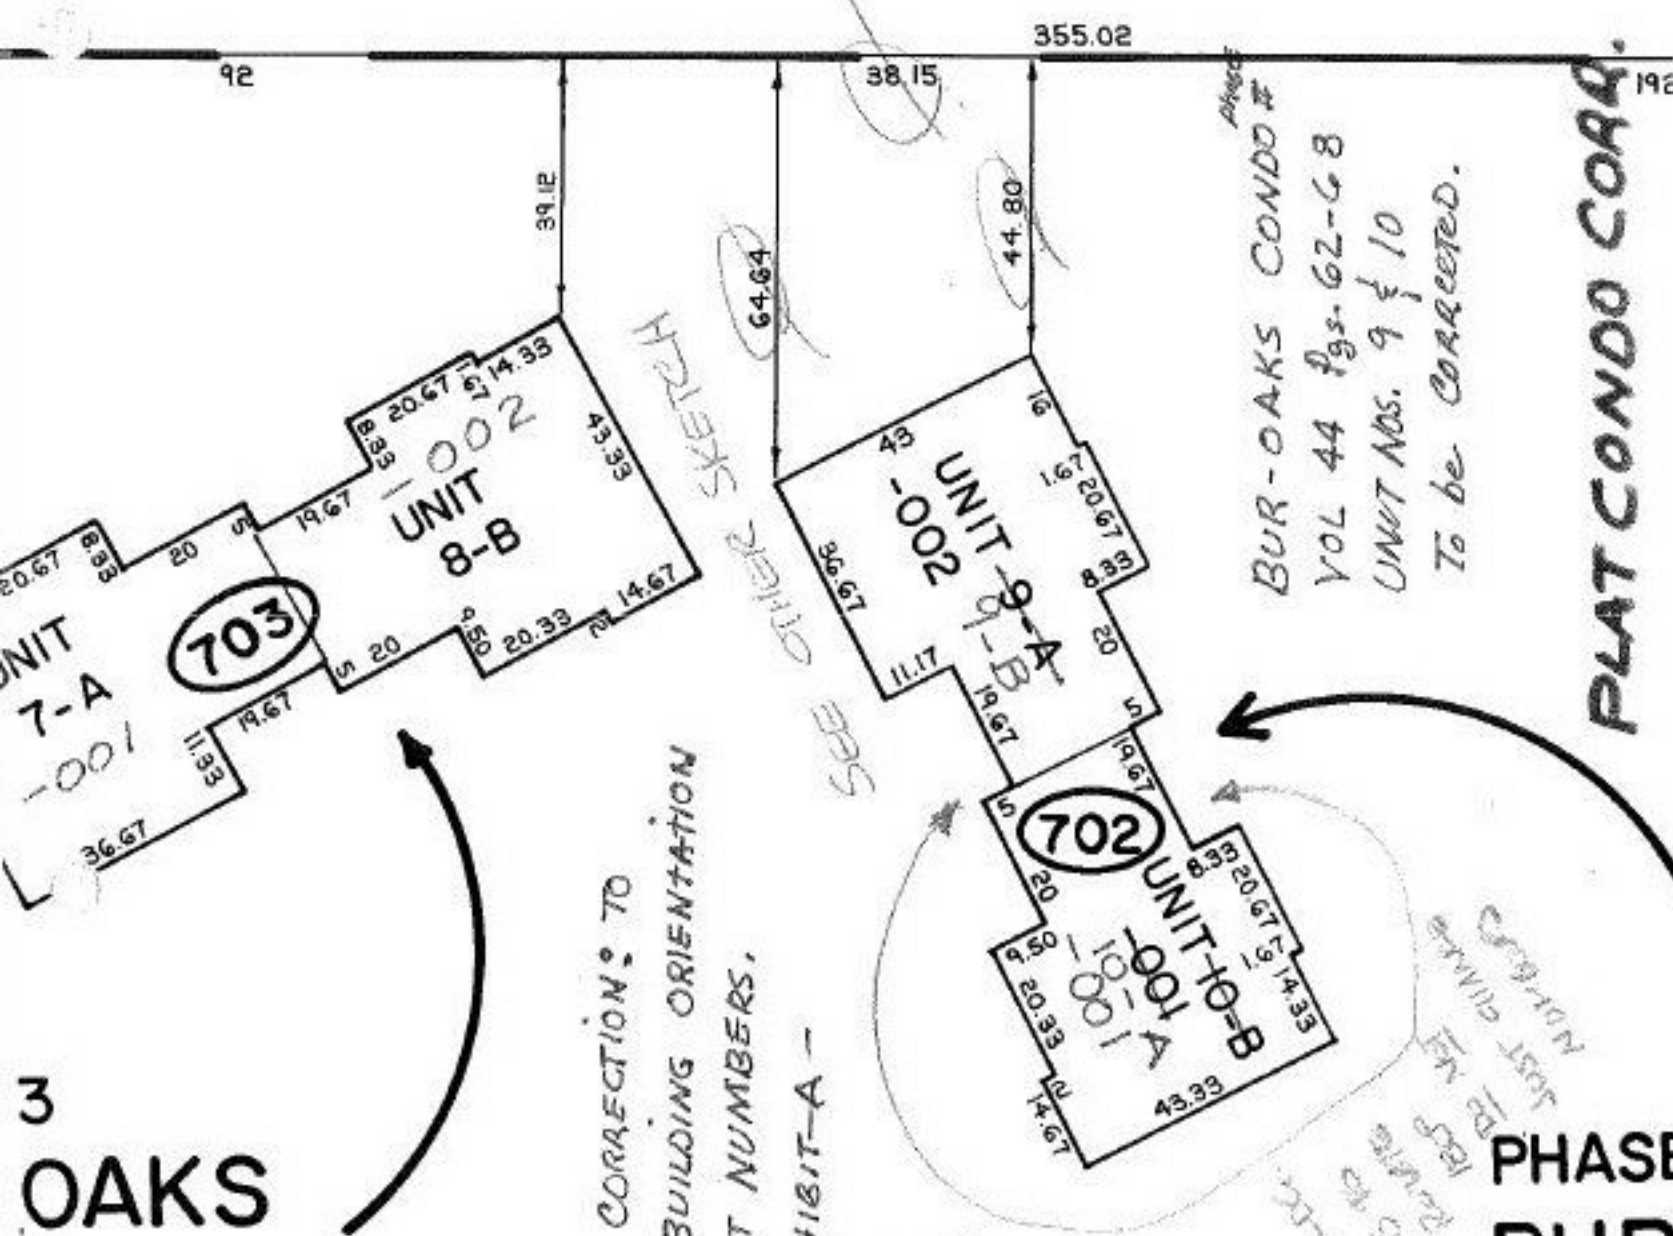

*This is a CORRECTION TO
CORRECT BUILDING ORIENTATION
AND UNIT NUMBERS.*

SEE EXHIBIT-A -

**SA 12/14/90
19004A**

APPROVED
LORAIN CO.
MAP DEPT.
DATE 8-10-90
PAGE 34-A
BY CAROLYN FRANCIS
VOID AFTER # 19004A

**PHASE
BUR
CON
VOL.**

PLAT CONDO CORR.