


EXHIBIT - A -

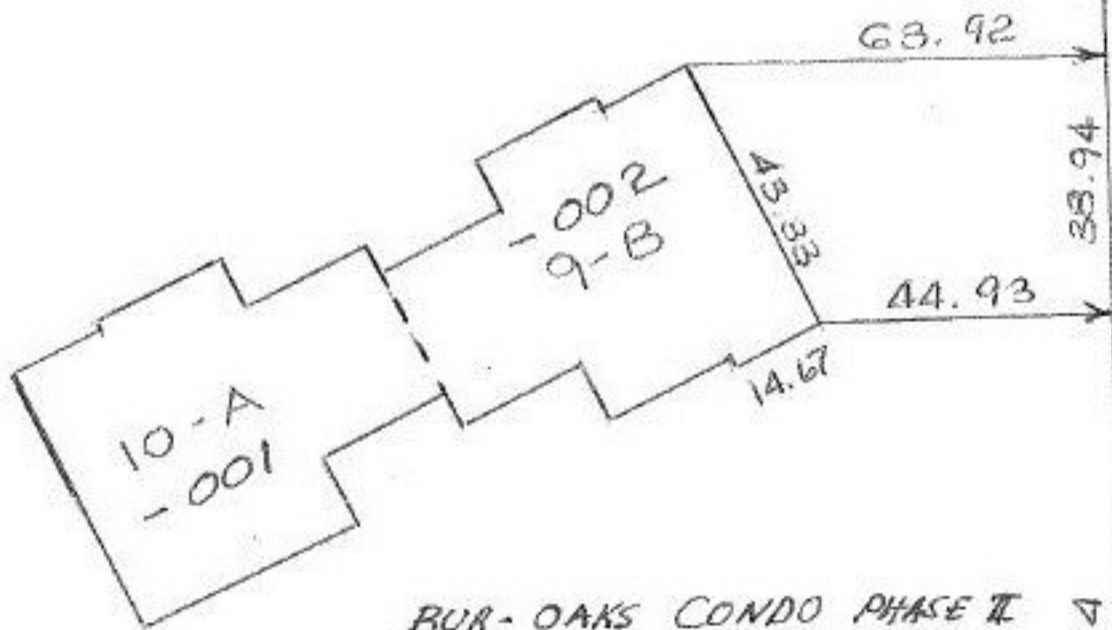

BUR-OAKS CONDO PHASE II
 VOL 44 PGS 62-68
 UNIT NOS. 9 & 10
 CORRECTION

192.84

BUENS RD PLAT CONDO. CORR.

SEE OR 301/816-7

19004 A

APPROVED LORAIN CO. MAP DEPT.
DATE 8-10-90
PAGE 6-34-A BY CAROLYN FRANCIS
VOID AFTER # 19004A