

PLAT CONDO CORR.

PHASE 3  
BUR-OAKS  
CONDOMINIUM  
VOL. 45 PGS. 48-54

SEE OTHER SKETCH


BEDS  
HAVE TO  
ROTATE 180  
DO NOT  
JUST CHANGE  
NUMBERS

THIS CORRECTION IS TO CORRECT BUILDING ORIENTATION - THE LOCATIONS & ORIENTATIONS OF BUILDINGS CONTAINING IN UNITS 7, 8

SEE EXHIBIT - A - 1

# 19004A

APPROVED  
LORAIN CO.  
MAP DEPT.  
DATE 8-10-90  
PAGE 6-34-A  
BY CAROLYN FRANCIS  
VOID AFTER # 19004A

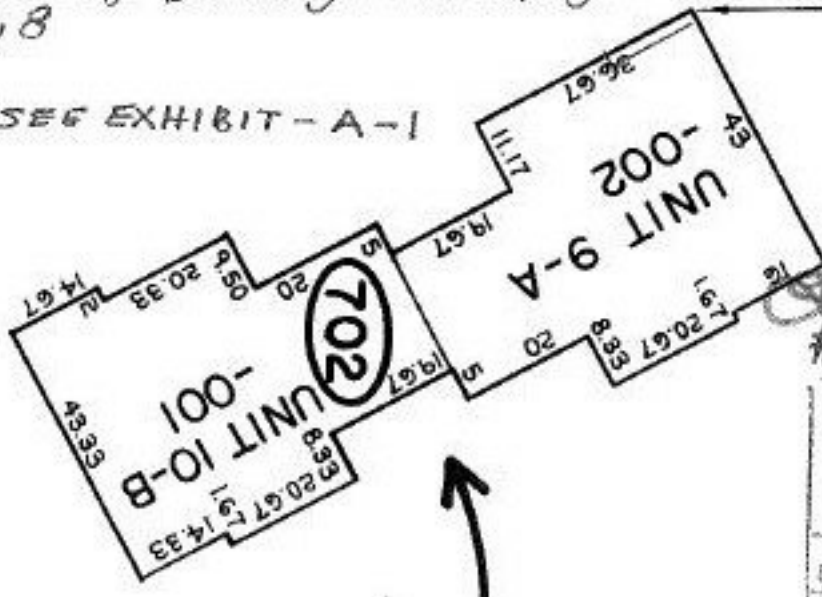

12/14/90  
# 19004A

APPROVED  
LORAIN CO.  
MAP DEPT.  
DATE 8-10-90  
PAGE 6-34-A  
BY CAROLYN FRANCIS  
VOID AFTER # 19004A

355.02