


16-00-021-01-014

19005-A

12-00-021-A

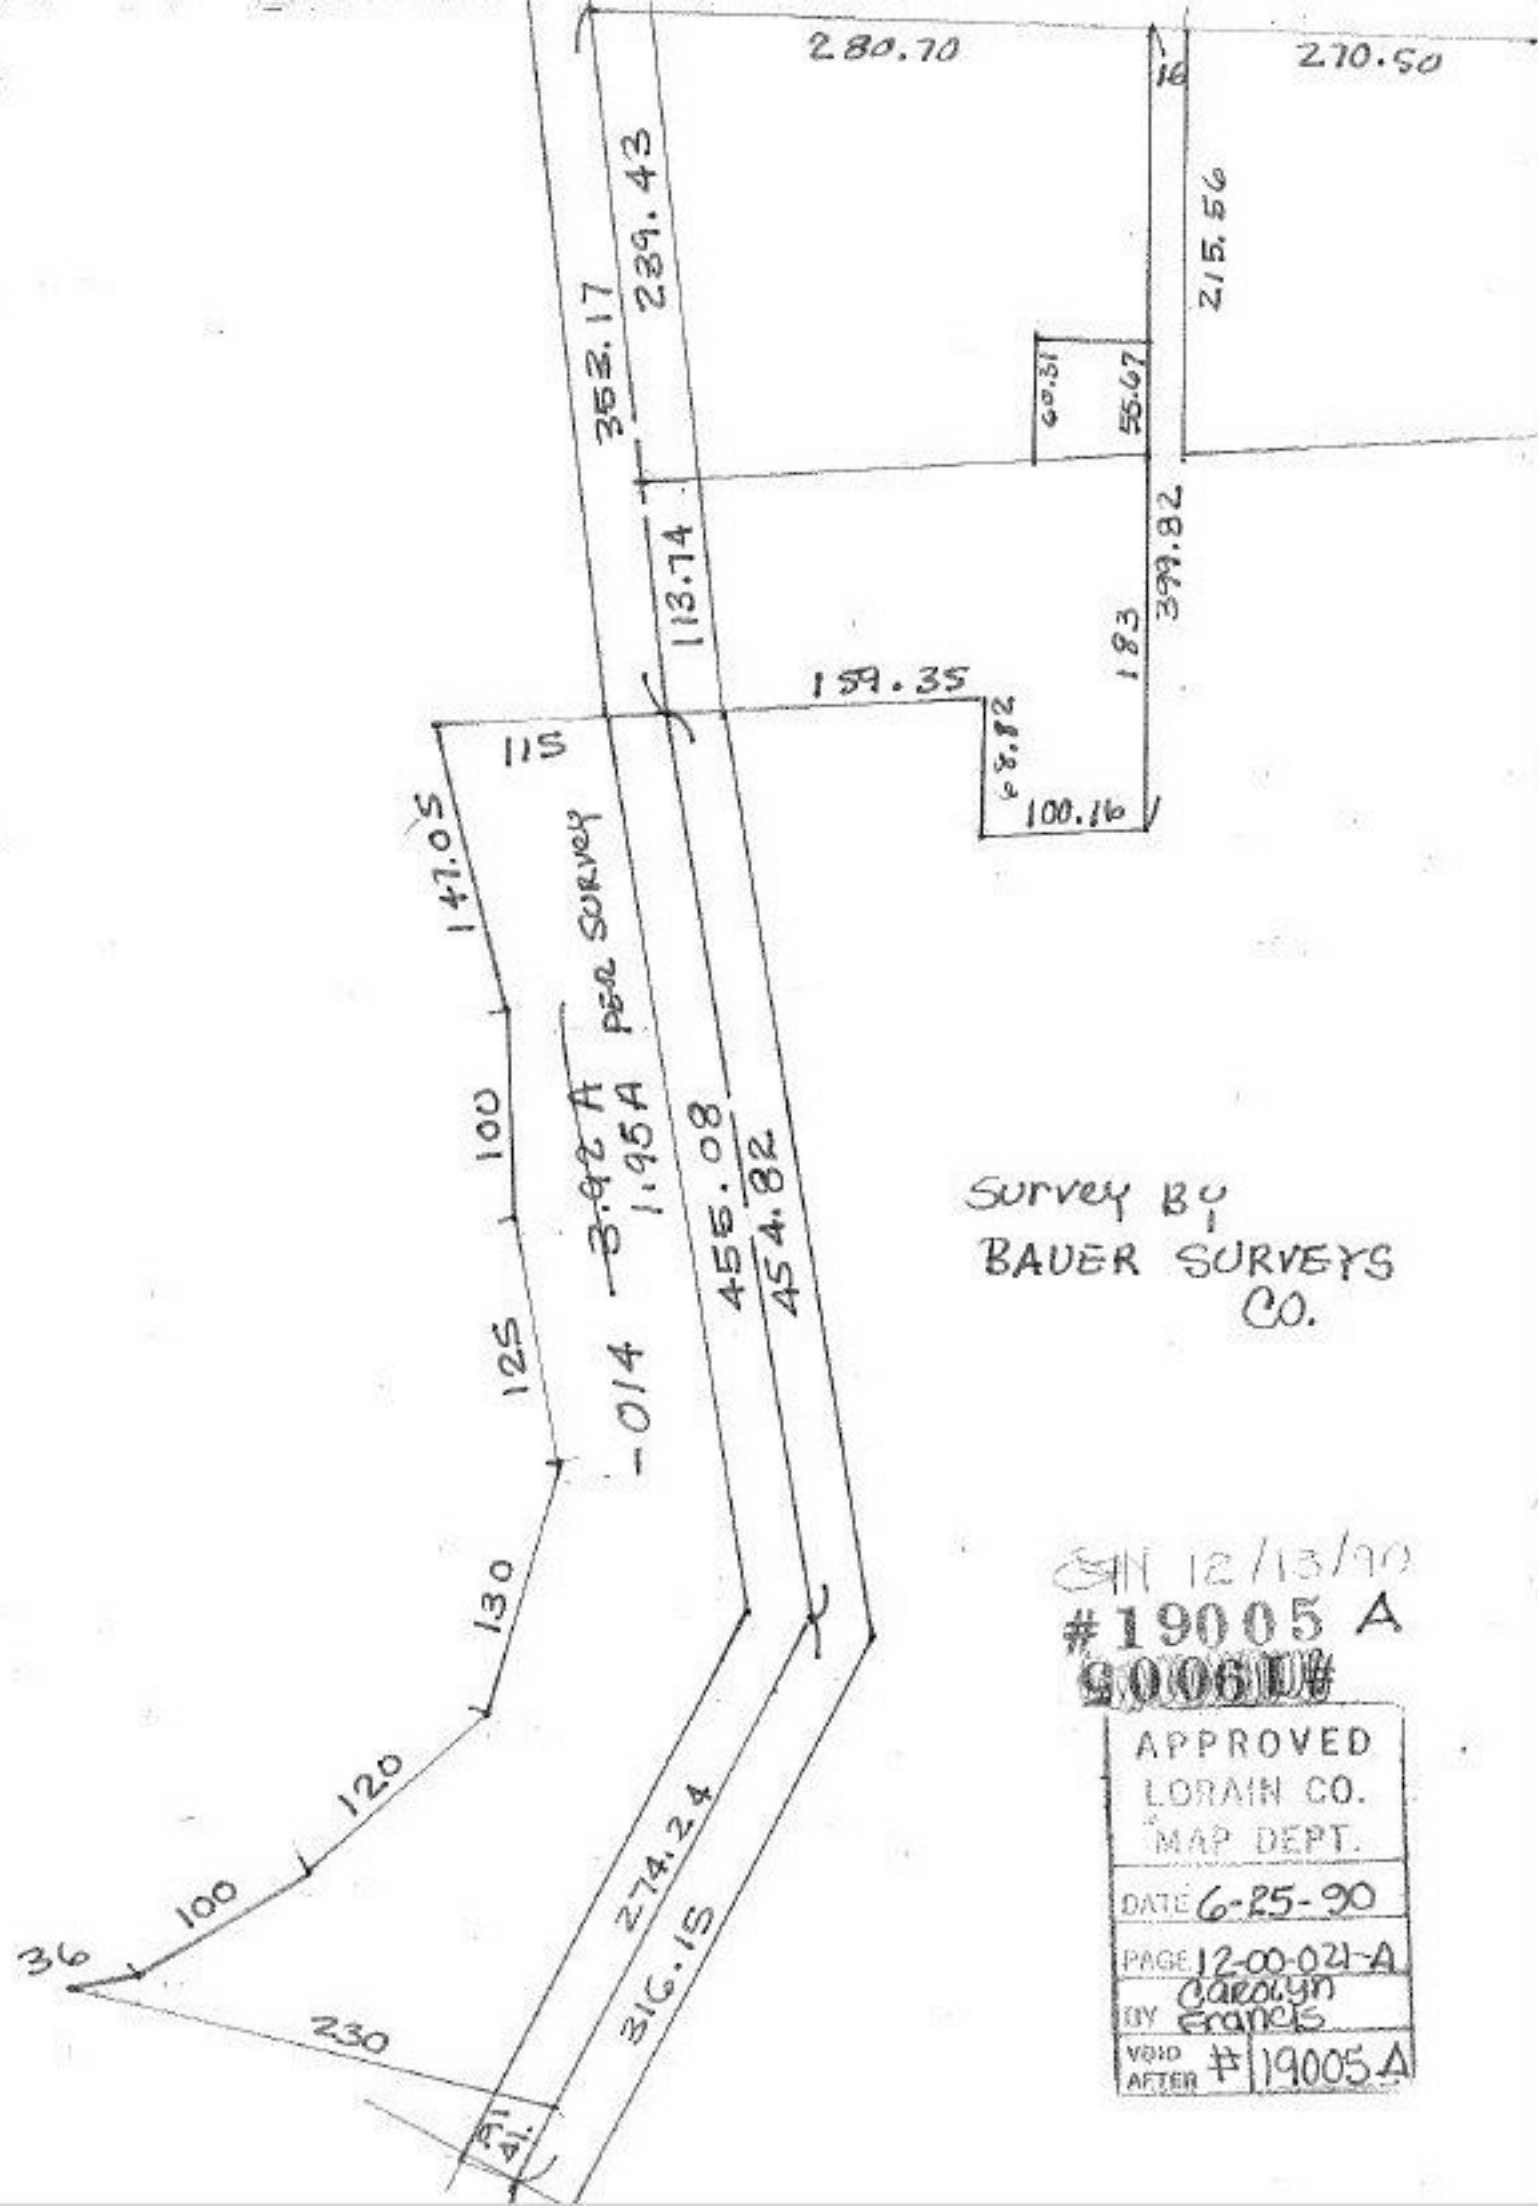

Survey by  
BAUER SURVEYS  
CO.

SIN 12/13/90  
#19005 A  
~~900610~~

APPROVED LORAIN CO. MAP DEPT.	
DATE	6-25-90
PAGE	12-00-021-A
BY	Carolyn Francis
VOID AFTER	#19005 A