




(105)

Pt. -020
 Pt. 100.77A
 100.46A

AC. CORR.

BAUER
 SURVEYS
 CO.
 C=1:100000

SEE 12-00-02

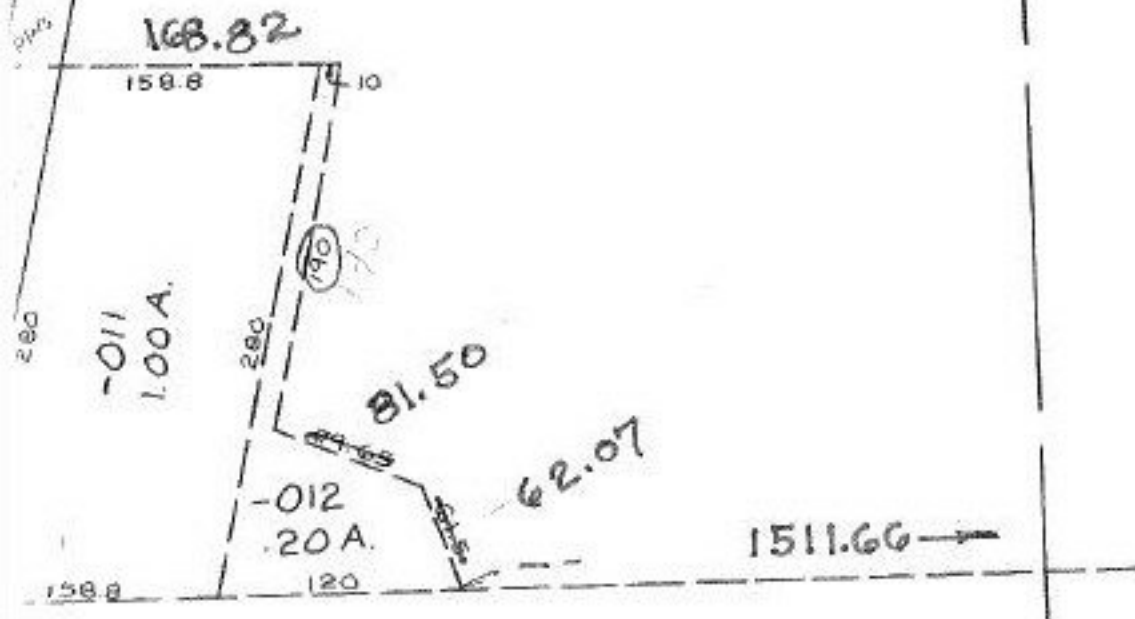

Pt. -027
 Pt. 7.73A.

SIN 12/13/90
 #19005 A

APPROVED
 LORAIN CO.
 MAP DEPT.
 DATE ~~12-10-90~~ 6-25-90
 PAGE ~~12-00-020~~ A
 BY CAROLYN FRANCIS
 VOID AFTER #19005-A