

SEE 12-00-021-B

101

-003


15-20A:

16.75 A

Ac. Corr. Per Survey
by Thomas Powers Reg. Surveyor

C=1:1000,000.

1976.05 To & REDFERN RD. 1/4 NE COR. PARCEL.

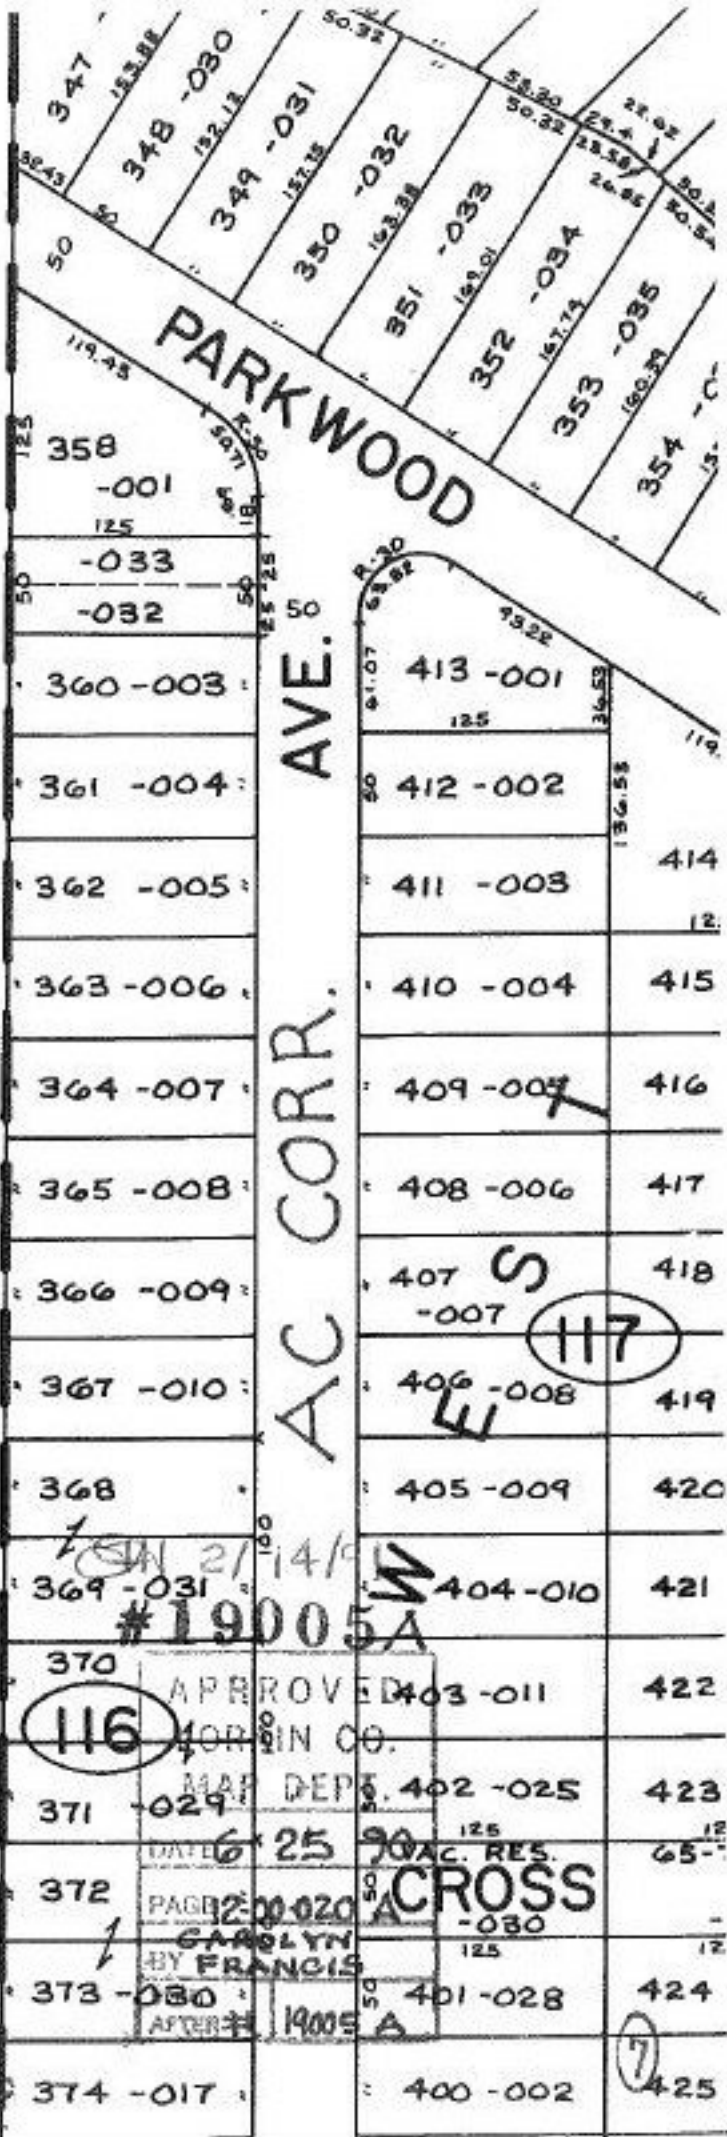

12-00-020-101-003

REDFERN RD

Along & 354.05 &

7