


SM 12/13/70

#19005 - A

APPROVED
DRAIN CO.
MAP DEPT.
DATE 12-10-90
PAGE 12-00-021-B
BY Carolyn FRANCIS
VOID NUMBER # 19005 - A

ORIGINAL

3/3

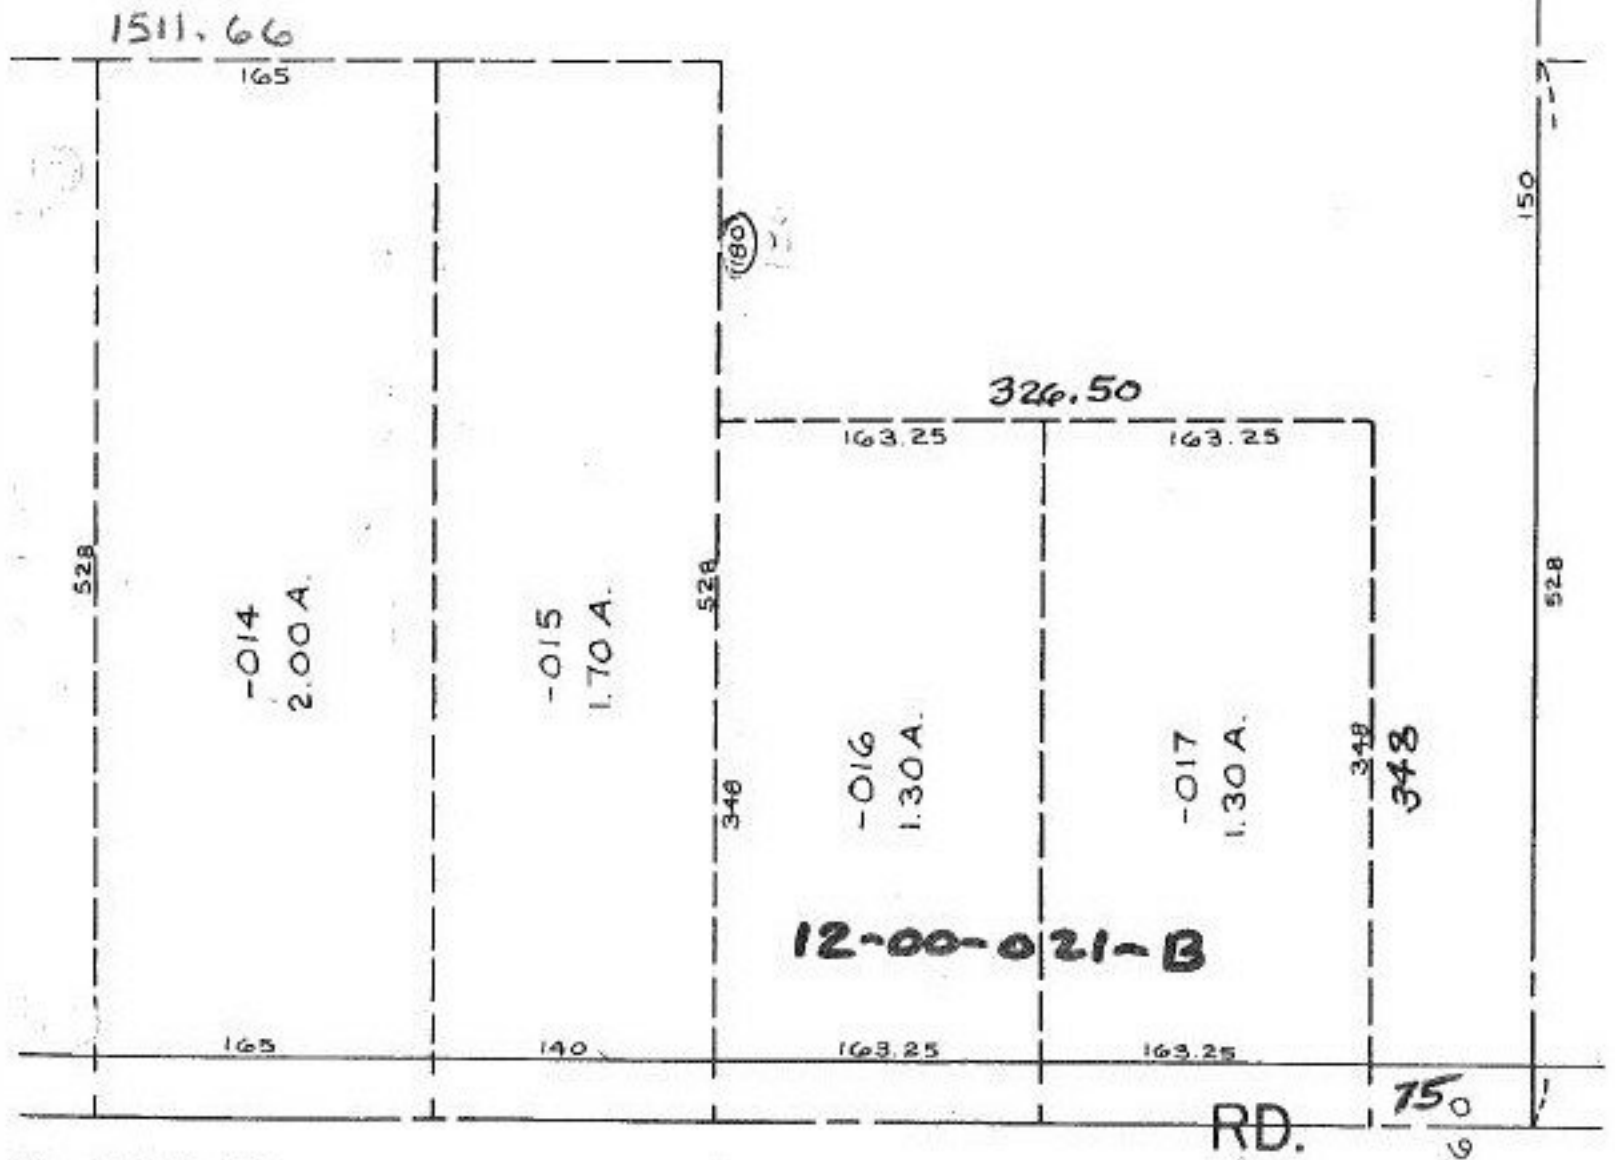

0-022-B