

BIGGS

RD.

60


NON.

-014
16.93A.

150.00
129.50
20.50

0.69
- 0.60
0.09A

SCALING ERROR, FOR TRUE SCALE
SEE SPLIT MAP #19081-A

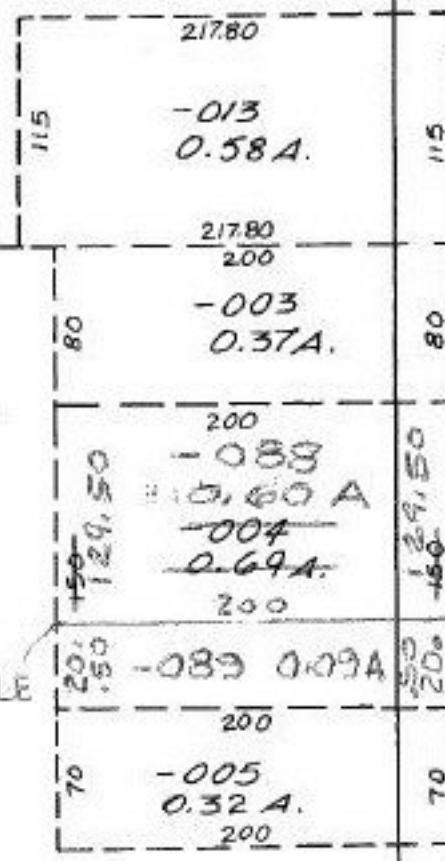

577.50 RD.

ELYRIA LAGRANGE RD

643.00
See John Postmark

MAP DIMENSIONS (P.M. 11/7/92)
80.00
+ 577.50 NOT A RESULT OF SURVEY
657.50

1/23/91
19020
 APPROVED
 LORAIN CO.
 MAP DEPT.
 DATE 6-29-90
 PAGE 15-00-036
 BY CAROLYN FRANCIS
 VOID AFTER # 19020

15-00-036-000- PRIOR INST. 1253/346
 SURVEYED BY: JOHN POZYWAK REG. SURVEYOR
 C=1:INF.