


GRISWOLD RD

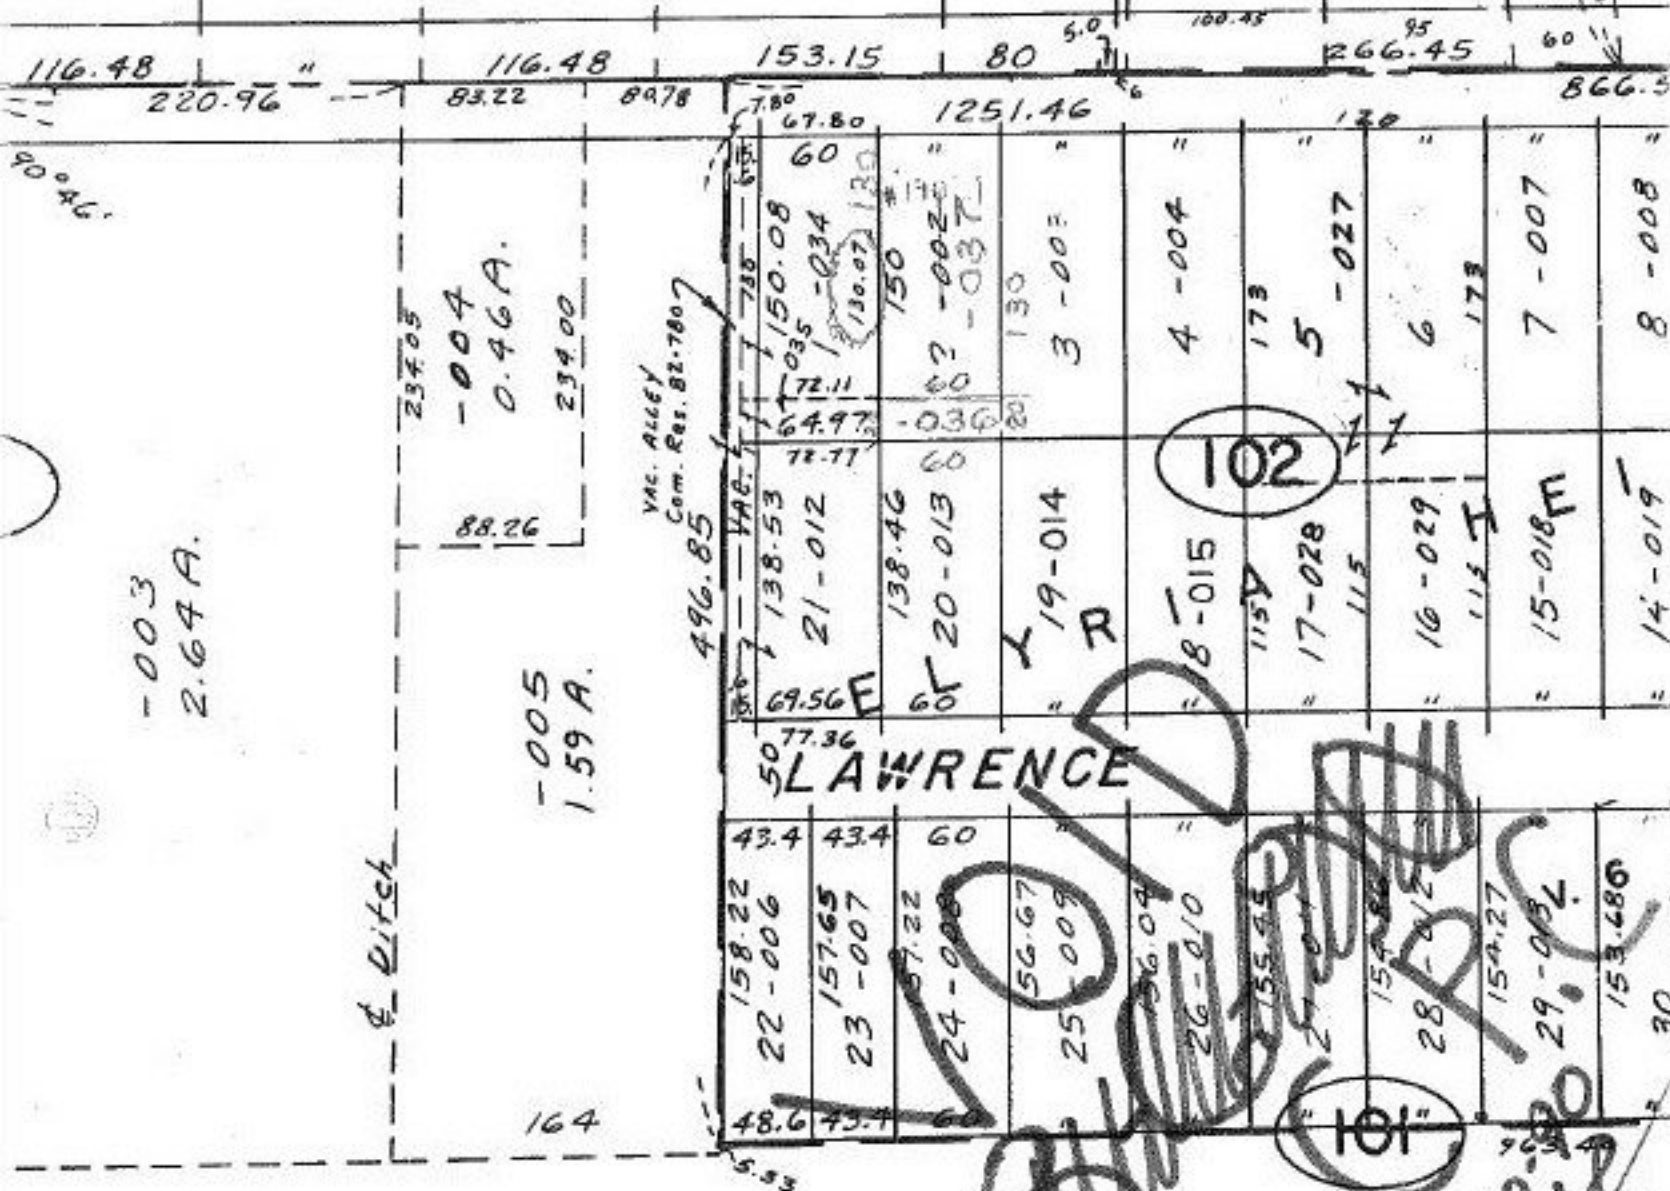

-003  
2.64 A.

-004  
0.46 A.

-005  
1.59 A.

Ditch

VAC. ALLEY  
Com. Res. 82-7807

LAWRENCE

102

101

38

06-24-038-102- PRIOR INST. 1081/131  
SURVEYED BY: MCGLINCHY & ASSOC. C=1:INF.

12/14/10  
#19021  
APPROVED  
LORAIN CO.  
MAP DEPT.  
DATE 7-2-90  
PAGE 6-42  
BY CAROLYN  
FRANCIS  
VOID AFTER # 19021

101