


IRON PINE



STATION RD.

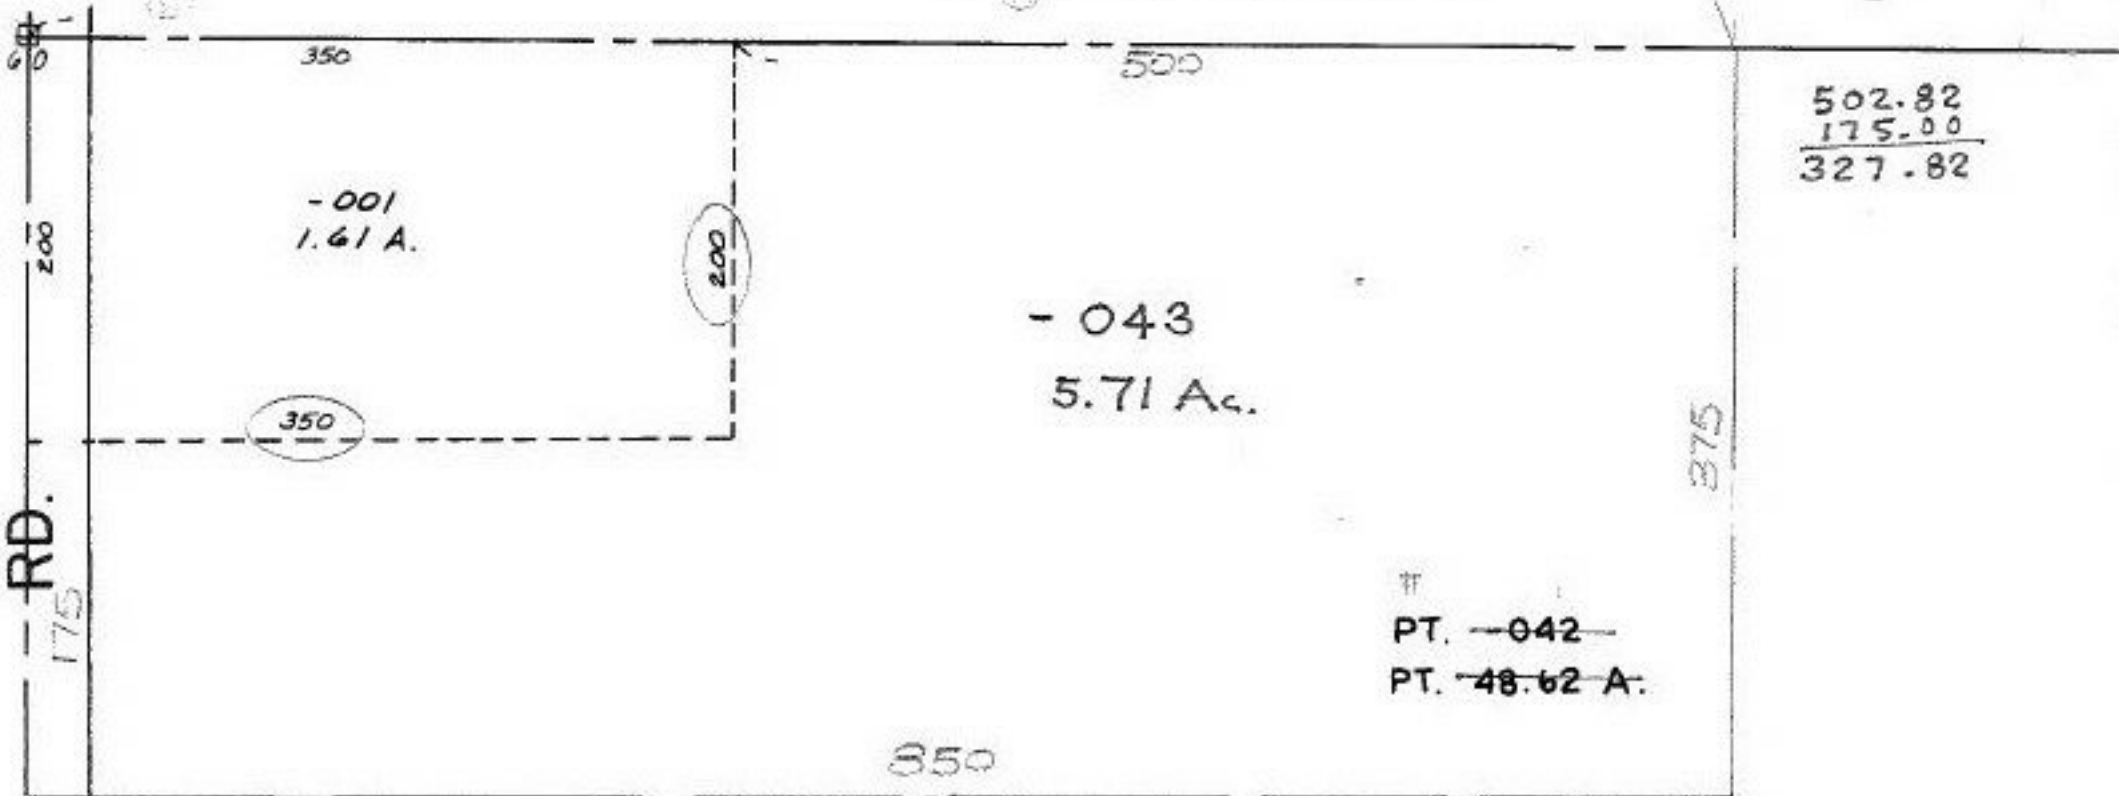