


#19035
 Pt. ~~073~~ -075
 Pt. 4.67A 4.47 A

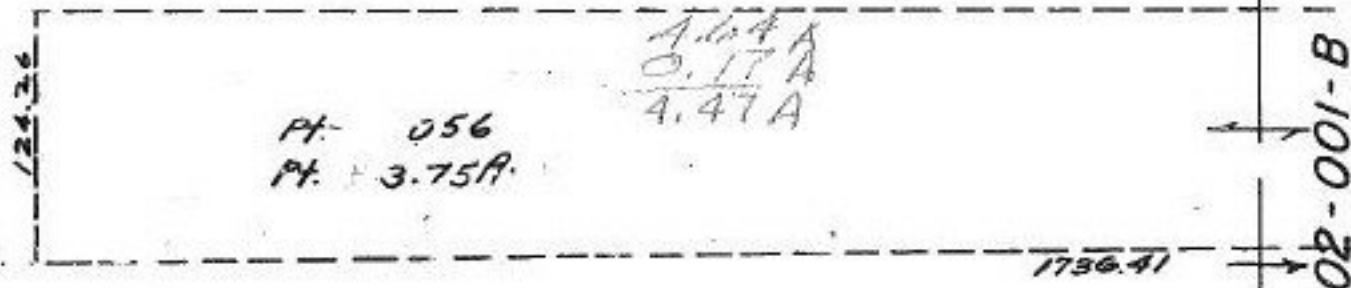

02-02-001-104- PRIOR INST. _____

Pt. 054
 Pt. 14.32A

12/11/90
 #19035

| | |
|-------------------------------------|-------|
| APPROVED LORAIN CO. MAP DEPT. | |
| DATE 7-9-90 | |
| PAGE 2-02-001 A | |
| BY CAROLYN FRANCIS | |
| VOID AFTER # | 19035 |

SEE 2-02-001-B