

53 32 29 30

(115)

121.55
106.61

14.94

pt 14.13
108.57

OHIO

22.10
37.36

59.46

102.53
50.94


51.64

13.50
50.10

63.50

MAR 17
CORR

NORTHEAST

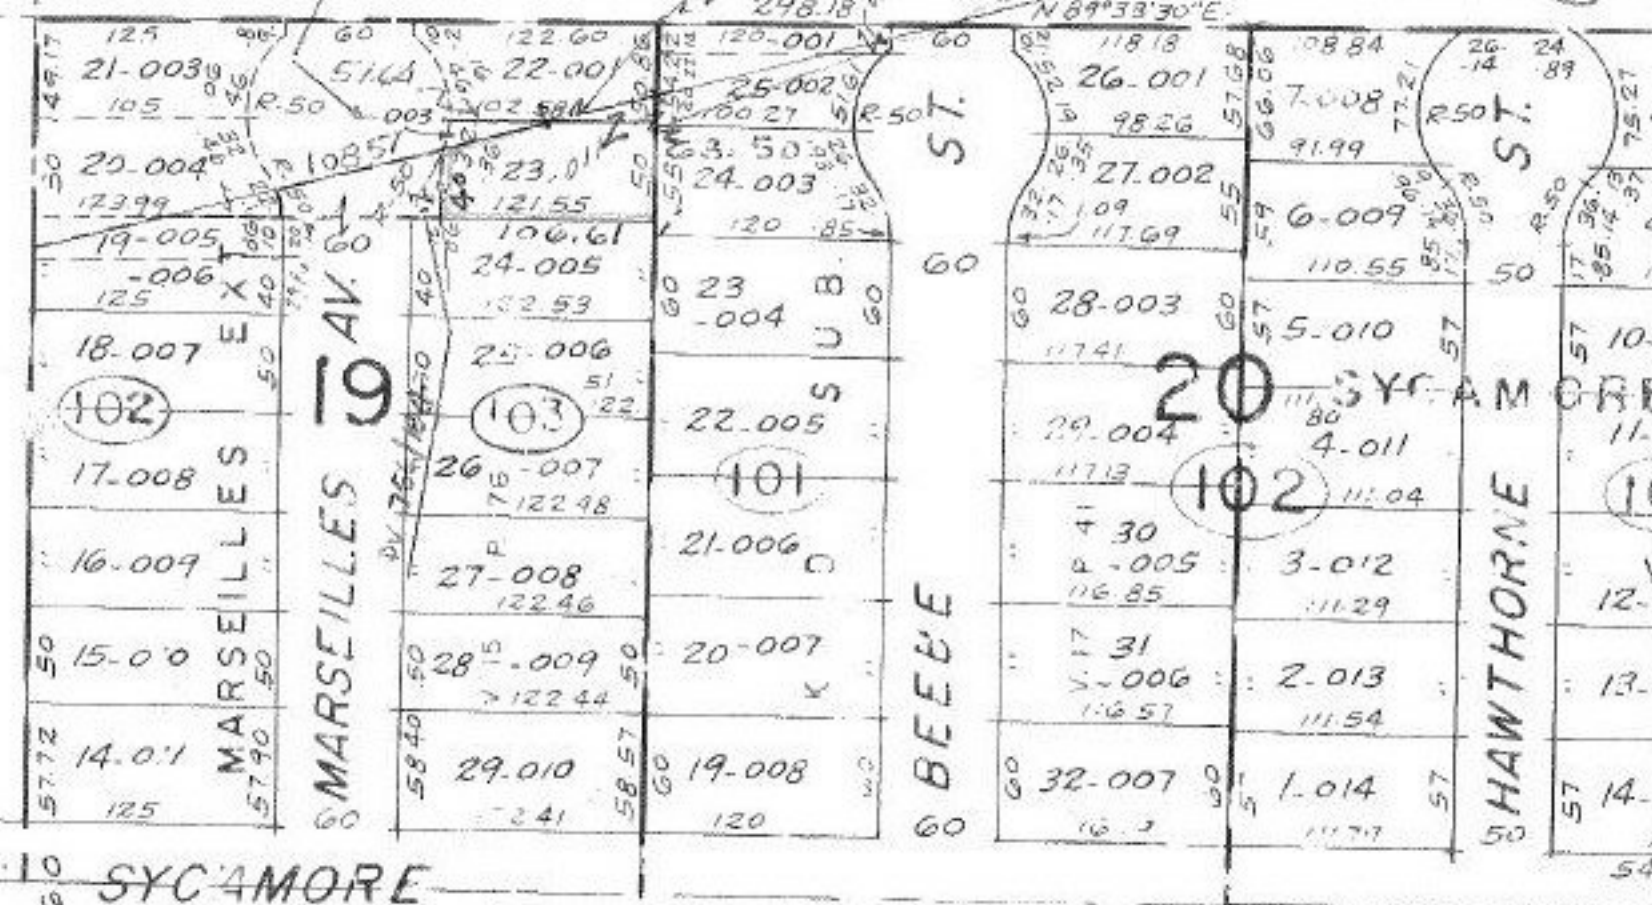

FRONTAGE & DEPTH CORR.
PER TAX MAP DEPT.
DY. 756/184, 186
06-25-019-103-011

12/14/90 SFF 6-88
#19037 A MAP

APPROVED
LORAIN CO.
MAP DEPT.
DATE 7-13-90
PAGE C-70
BY CAROLYN FRANKS
VOID AFTER #19037A

CORR.
EAST C
E ly
M ly

ELYRIA

SCALE 1" = 100'