


SEE FILE FOLDER  
KOBÉ/LORAIN INC.

ALSO SEE PIGEON  
HOLE 120

PT. 29.98A  
PT. 29.98A

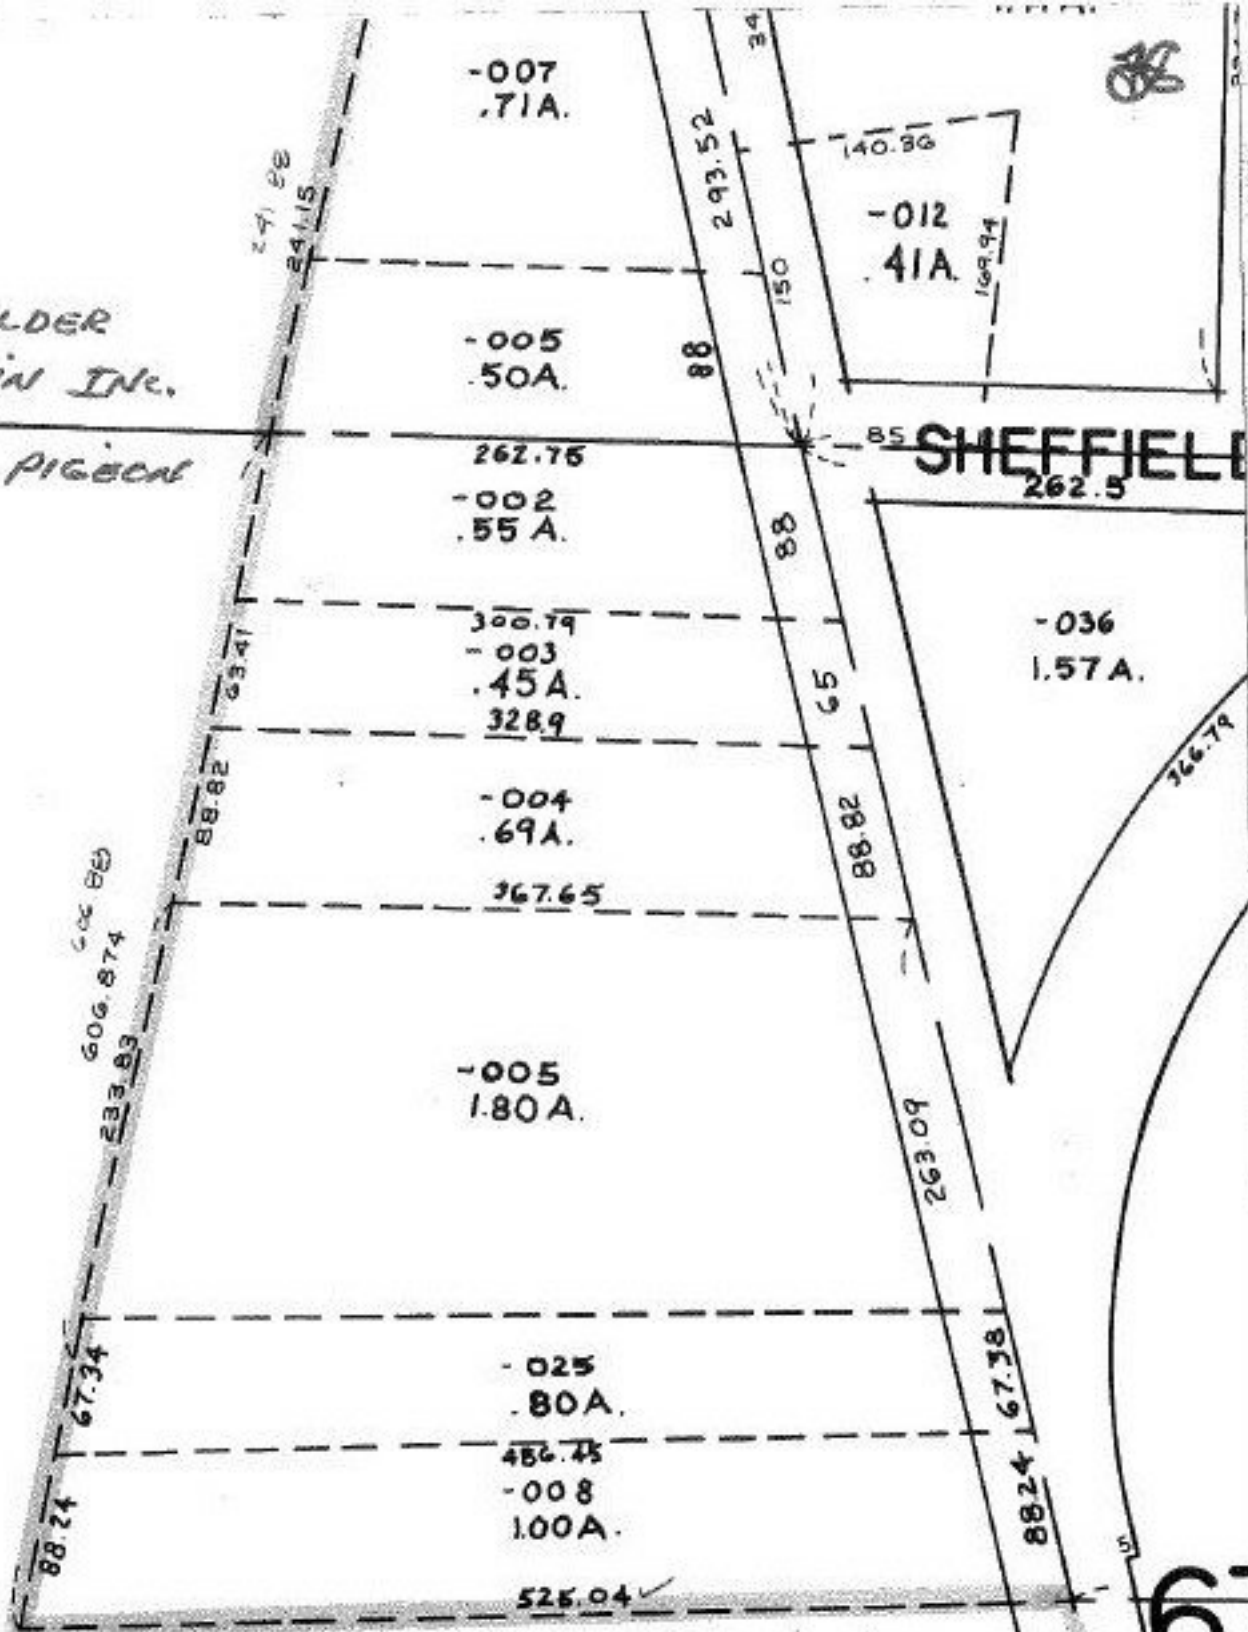

**#19044**

SA 1/11/91

APPROVED LORAIN CO. MAP DEPT.	
DATE 7/17/90	
PAGE 3-00-066-B	
BY	<i>[Signature]</i>
VOID AFTER	19044

COURSE 127  
207B.92