
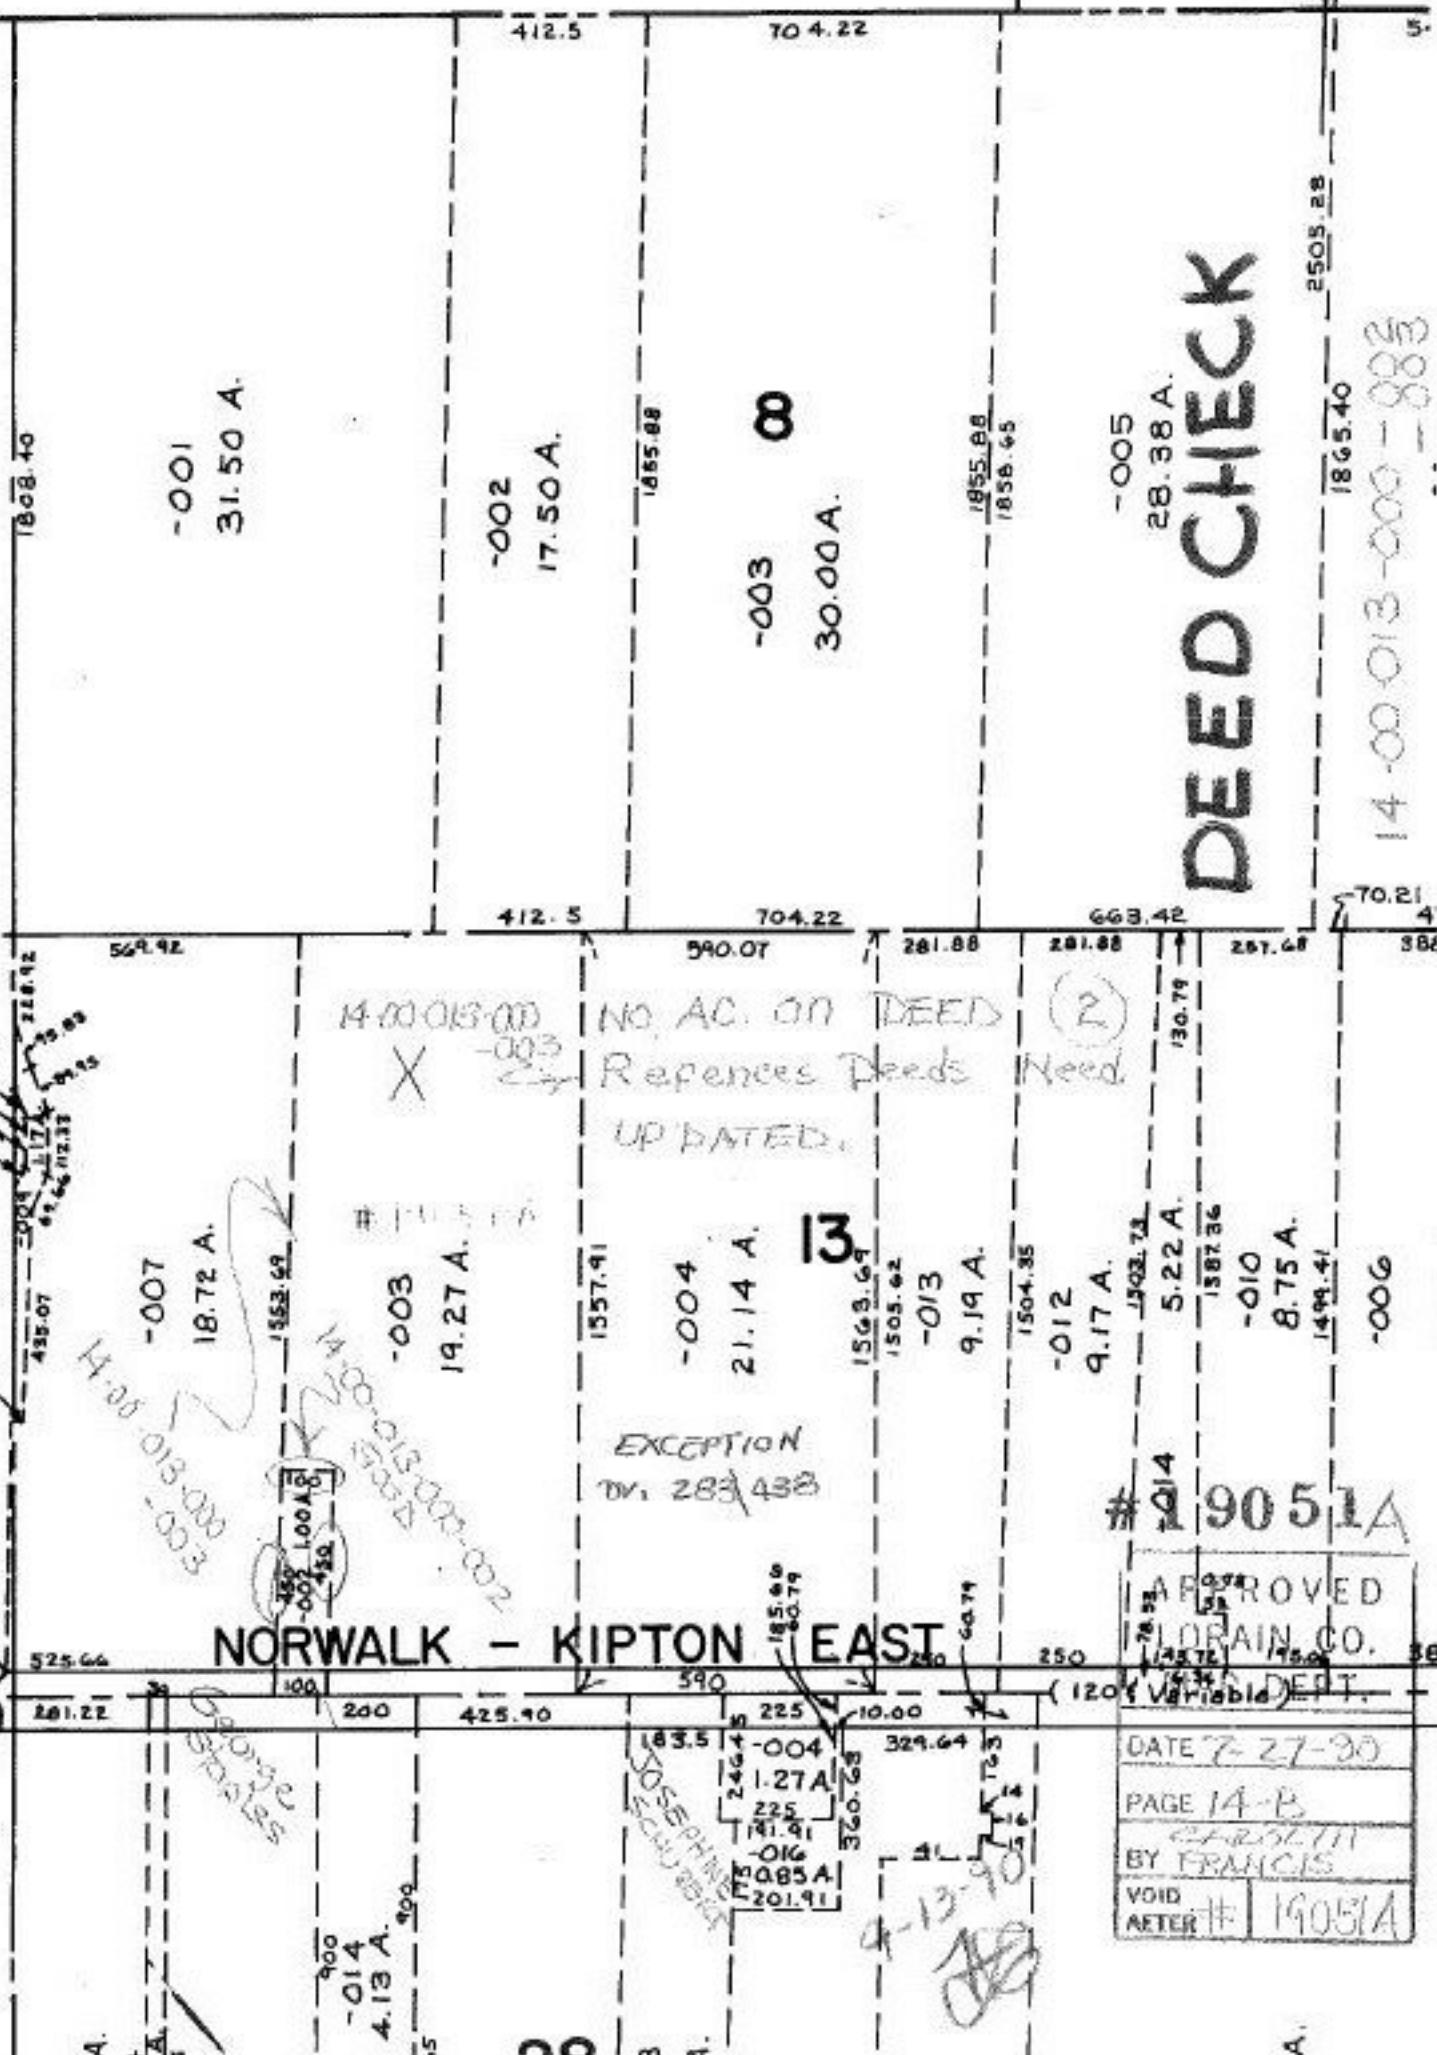


20

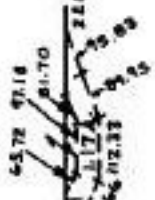

NORWALK - KIPTON EAST

Accepted for Record

14-00013-00 NO. AC. ON DEED (2)  
X -003 References Deeds Need  
UP DATED.

14-00013-003  
14-00013-002  
14-00013-001  
14-00013-000

EXCEPTION  
BY 283 438

SEP 19 1930  
RECORDED

9-13-30

APPROVED
LORAIN CO.
CLERK
BY FRANCIS
VOID AFTER # 19051A

DATE 7-27-30

PAGE 14-B

BY FRANCIS

VOID AFTER # 19051A

DEED CHECK

-001  
31.50 A.

-002  
17.50 A.

-003  
30.00 A.

-005  
28.38 A.

-007  
18.72 A.

-003  
19.27 A.

-004  
21.14 A.

-013  
9.19 A.

-012  
9.17 A.

-010  
8.75 A.

-006

1808.40

412.5

704.22

1855.88

1855.88  
1858.65

2505.28

1865.40

70.21

14-00-013-000-883

382

4

5