



237.96  
314.64  
7.32


RD. 180

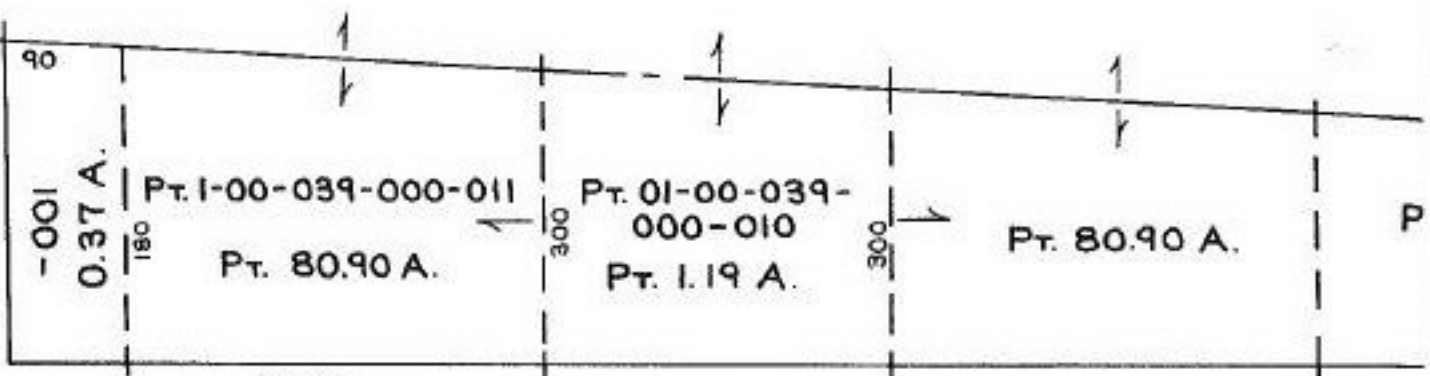

**NORTH RIDGE**

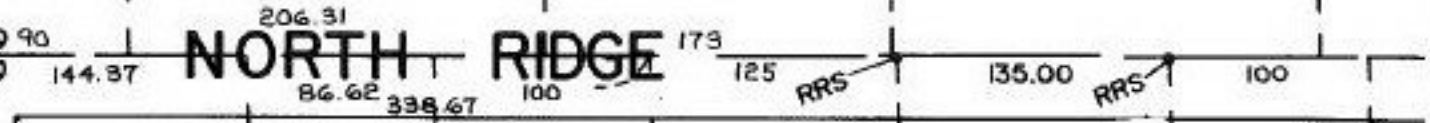

321.96  
314.64

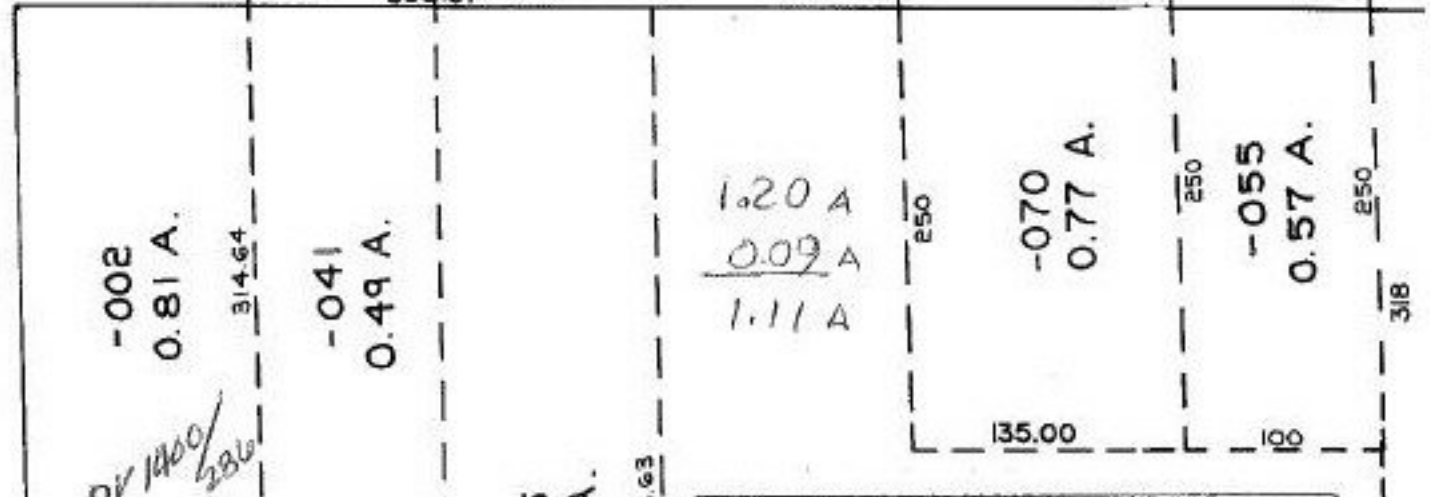

*DR 1400/286*

01-00-042-000- PRIOR INST. 1418/567  
SURVEYED BY: DAVID A. WILLIAMS  
C=1: INF. REG. SURVEYOR \*7166

BAUMHART RD

RRS  
75  
-000-  
0.075  
0.09A  
75



SIN 12/7/90  
#19054

APPROVED  
LORAIN CO.  
MAP DEPT.  
DATE 7-24-90  
PAGE 1-00-042A  
BY FRANCIS  
VOID AFTER #19054