

-017
6.28 A.

-010
1.15 A.

451
81
200

335

208
469.70

90

-024

~~2.13 A~~

2.12 A

PER SURVEY
KS ASSOC.
C=1:250,000

217.44

155
165.00
R=74.11

155

2.85
195

-023

~~5.98 A~~

3.85 A

-022
5.45 A.

15-00-082-000- PRIOR INST. OR. 310/
SURVEYED BY: KS ASSOC. ② 413
(1) C=1: 142,857 1:250,000

1007.38

502.70

111.76.77

111.68.20

290.58

92.99

4.99


183.67

PHEASANT RUN DR.
SEE 15-00-099-B

1/23/91
19067

APPROVED
LORAIN CO.
MAP DEPT.
DATE 8-3-90
PAGE 15-00-082-B
BY CAROLYN
FRANCIS
VOID AFTER # 19067

PHEASANT RUN VILLAGE PHASE I
P.V. 27 P. 16-19

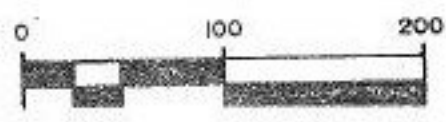

TWD