


RD.

60

577.50 RD.

-014
16.93A.

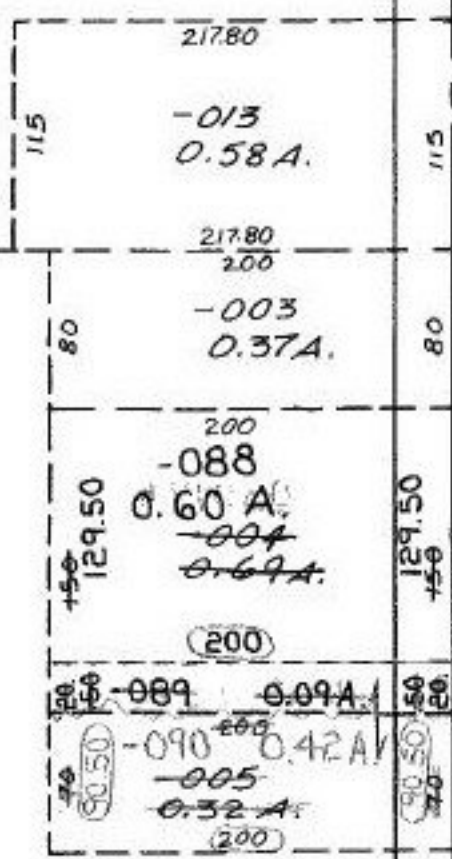

COMBINATION

SURVEYED BY JOHN POZYWAK
PRIOR DEED 1253 / 346

SN 1/23/91
#19081-A
COMBINATION

APPROVED
LORAIN CO.
MAP DEPT.
DATE 8/8/90
PAGE 15-00-036 B
BY T. HOLLIS
VOID AFTER 19081-A